

Leflore  
OA 74  
4-25-81

MISSISSIPPI DEPARTMENT OF NATURAL RESOURCES  
 Bureau of Land and Water Resources  
 Southport Mall  
 P.O. Box 10631

Jackson, Mississippi 39209  
**WATER WELL DRILLERS LOG**

**CODED**

4-25 19 81 Dyer Leflore  
 date well completed firm name county well located

**LANDOWNER:**  
Prudential Insurance  
Suite 513 White Station  
Conway, Ark  
 (mailing address)


description of fomations encountered	from	to
<u>Jewel Bedg</u>		
<u>CLAY</u>	<u>0</u>	<u>15</u>
<u>FINEL SAND</u>	<u>15</u>	<u>40</u>
<u>SAND Gravel</u>	<u>40</u>	<u>113</u>

**WELL LOCATION:**  
 sec. 25 T 22N S R 2 E W  
2 miles W of Porter City  
 (distance) (direction) (nearest town)

**WELL PURPOSE:** Irrigation  
 (home, irrigation, municipal, industrial)

- WELL COMPLETION DATA:**
- (1) diameter (inches) 16"
  - (2) total depth (feet) 113'
  - (3) static water level (feet) 21' below above top of ground.
  - (4) casing Steel, 106' (material) (depth)  
16" If telescope see back. (size)
  - (5) screen 40', 66' (length) (depth to top)  
16", Steel (size) (material)
  - (6) pump 60, 3000 (HP) (yield gpm)  
Piesel (type power)
  - (7) electric log \_\_\_\_\_ (yes or no)  
 \_\_\_\_\_ (organization running log)
  - (8) how well bottom plugged plate


**CODED**

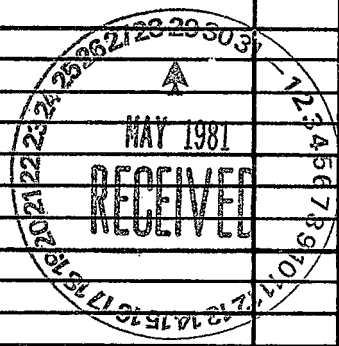

**DRILLERS REMARKS:**  
 \_\_\_\_\_  
 \_\_\_\_\_  
 \_\_\_\_\_

If well telescopes please sketch and show depths.

GROUND LEVEL

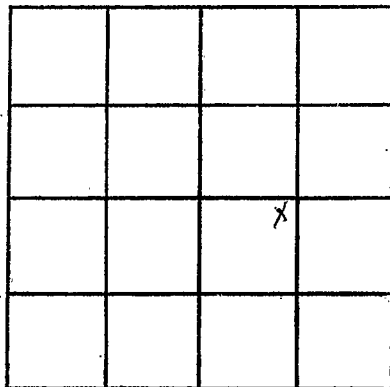

SECTION 25

Please indicate well location X.

ADDITIONAL INFORMATION

If more than one screen,  
show locations of each on sketch.