

Leflore
A75
4-28-81

MISSISSIPPI DEPARTMENT OF NATURAL RESOURCES
 Bureau of Land and Water Resources
 Southport Mall
 P.O. Box 10631
 Jackson, Mississippi 39209
WATER WELL DRILLERS LOG **CODED**

4-28-81 1981 Dyer Leflore
 date well completed from name county well located

LANDOWNER:

Prudential Insurance
Route 513 White Station
Conway - Minter City H.Q.
Memphis, Tenn (mailing address)

description of formations encountered

from to

<u>Clay</u>	<u>0</u>	<u>15</u>
<u>fine sand</u>	<u>15</u>	<u>40</u>
<u>med sand & gravel</u>	<u>40</u>	<u>68</u>
<u>Coarse Sand & gravel</u>	<u>68</u>	<u>113</u>

WELL LOCATION:

sec. 25 T 22 N R. 2 E
2 miles W of Minter City
 (distance) (direction) (nearest town)


WELL PURPOSE: Domestic
 (home, irrigation, municipal, industrial)

WELL COMPLETION DATA:

- (1) diameter (inches) 16"
- (2) total depth (feet) 113'
- (3) static water level (feet) 20 below top of ground.
- (4) casing Steel, 113',
 (material) (depth)
16" If telescope see back.
 (size)
- (5) screen 40', 73'
 (length) (depth to top)
16", Steel
 (size) (material)
- (6) pump 60, 3000
 (HP) (yield gpm)
Diesel
 (type power)
- (7) electric log
 (yes or no)

 (organization running log)
- (8) how well bottom plugged plate

CODED

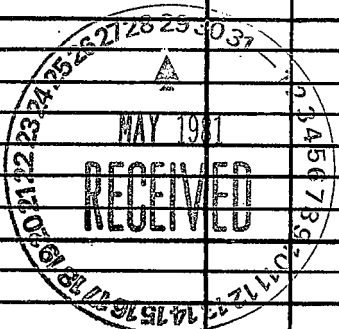

DRILLERS REMARKS:

If well telescopes please sketch and show depths.

GROUND LEVEL

	X		

SECTION 25

Please indicate well location X.

ADDITIONAL INFORMATION

If more than one screen, show locations of each on sketch.