

MISSISSIPPI DEPARTMENT OF NATURAL RESOURCES

Bureau of Land and Water Resources

Southport Mall

P.O. Box 10631

Jackson, Mississippi 39209

WATER WELL DRILLERS LOG


CODED

Leflore
R 76
5-2-81


date well completed: 5-2-1981 firm name: Apri Well Drilling county well located: Leflore

LANDOWNER: <u>D. W. Carter</u>	description of formations encountered	from	to
<u>Monter City</u> (mailing address)	<u>CLAY</u>	<u>0</u>	<u>16</u>
	<u>FINE SAND</u>	<u>16</u>	<u>34</u>
	<u>SANDY SILT</u>	<u>34</u>	<u>113</u>
<p>WELL LOCATION: sec. <u>30</u> T. <u>220</u> S. R. <u>2</u> E. W. <u>6</u> (distance) <u>6</u> miles <u>East</u> of <u>Palmerville</u> (direction) (nearest town)</p>			
<p>WELL PURPOSE: (home, irrigation, municipal, industrial)</p>			
<p>WELL COMPLETION DATA:</p>			
(1) diameter (inches) <u>16"</u>			
(2) total depth (feet) <u>113'</u>			
(3) static water level (feet) <u>22'</u> below top of ground.			
(4) casing <u>Steel</u> <u>113'</u> (material) (depth)			
<u>16"</u> if telescope see back. (size)			
(5) screen <u>40'</u> <u>73'</u> (length) (depth to top)			
<u>16"</u> <u>Steel</u> (size) (material)			
(6) pump <u>60</u> <u>3000</u> (HP) (yield gpm)			
<u>Diesel</u> (type power)			
(7) electric log _____ (yes or no)			
_____ (organization running log)			
(8) how well bottom plugged <u>plate</u>			

CODED

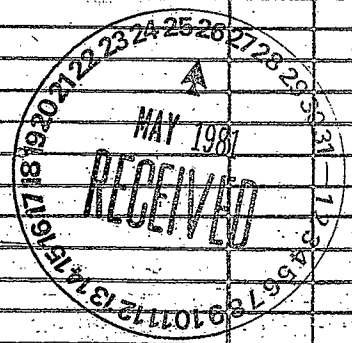

DRILLERS REMARKS:

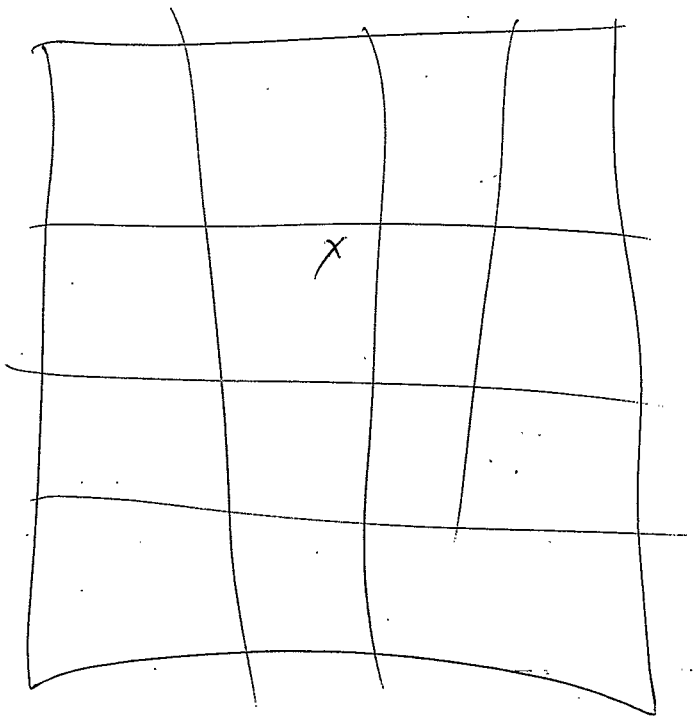

Sec 30.