

Leflore
VATT
520-80

MISSISSIPPI
 BOARD OF WATER COMMISSIONERS
 416 North State Street
 Jackson, Mississippi 39201

CODED

WATER WELL DRILLERS LOG

5/20 19 80 Dyer Leflore
 date well completed firm name county well located

LANDOWNER:
ED SCOTT
MINTER CITY, MS
 (mailing address)


description of formations encountered	from	to
<u>Clay</u>	<u>0</u>	<u>28</u>
<u>fine sand</u>	<u>28</u>	<u>38</u>
<u>sand</u>	<u>38</u>	<u>48</u>
<u>sand & gravel</u>	<u>48</u>	<u>112</u>

WELL LOCATION:
 sec. 9 T. 20 N. R. 2 E. S. 5
2 miles NW of Minter City
 (distance) (direction) (nearest town)

WELL PURPOSE:
 (home, irrigation, municipal, industrial)

- WELL COMPLETION DATA:
- (1) diameter (inches) 16"
 - (2) total depth (feet) 112'
 - (3) static water level (feet) 19' below top of ground.
 - (4) casing Steel, 112'
 (material) (depth)
16" if telescope see back.
 (size)
 - (5) screen 40', 72'
 (length) (depth to top)
16", Steel
 (size) (material)
 - (6) pump 60, 3000
 (HP) (yield gpm)
Propane
 (type power)
 - (7) electric log (yes or no) _____
 (organization running log) _____
 - (8) how well bottom plugged plate


CODED

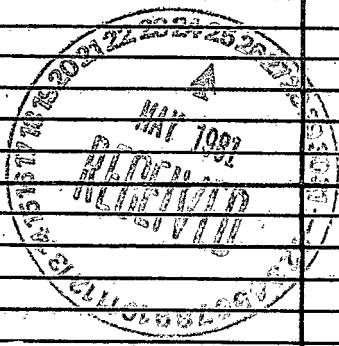

DRILLERS REMARKS:

If well telescopes please sketch and show depths.

GROUND LEVEL

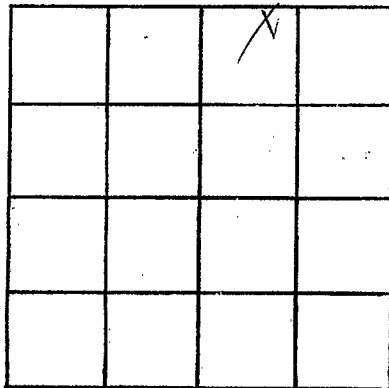

SECTION

9

Please indicate well location X.

ADDITIONAL INFORMATION

If more than one screen, show locations of each on sketch.