

Leflore
 # 78
 3-27-80

MISSISSIPPI
 BOARD OF WATER COMMISSIONERS
 416 North State Street
 Jackson, Mississippi 39201

CODED

WATER WELL DRILLERS LOG


3/27 1980
 date well completed

Dyer
 firm name

Leflore
 county/well located

LANDOWNER:	description of formations encountered	from	to
<i>BUDDY ALANT</i>			
<i>ROLEVILLE MS.</i> (mailing address)	<i>Clay</i>	<i>0</i>	<i>29</i>
	<i>fine sand</i>	<i>29</i>	<i>38</i>
	<i>sand</i>	<i>38</i>	<i>48</i>
	<i>sand & gravel</i>	<i>48</i>	<i>103</i>
WELL LOCATION: sec: <i>30</i> T <i>22</i> N R <i>2</i> E <i>6</i> S <i>W</i> <i>6</i> miles <i>E</i> of <i>Rollville</i> (distance) (direction) (nearest town)			
WELL PURPOSE: (home, irrigation, municipal, industrial)			
WELL COMPLETION DATA:			
(1) diameter (inches) <i>12"</i>			
(2) total depth (feet) <i>103'</i>			
(3) static water level (feet) <i>22'</i> below top of ground.			
(4) casing <i>Steel</i> , <i>103'</i> (material) (depth) <i>12"</i> (size) if telescope see back.			
(5) screen <i>40'</i> , <i>63'</i> (length) (depth to top) <i>12"</i> , <i>Steel</i> (size) (material)			
(6) pump <i>40</i> <i>2000</i> (HP) (yield gpm) <i>Variable</i> (type power)			
(7) electric log (yes or no)			
(organization running log)			
(8) how well bottom plugged <i>plate</i>			
DRILLERS REMARKS:			


CODED

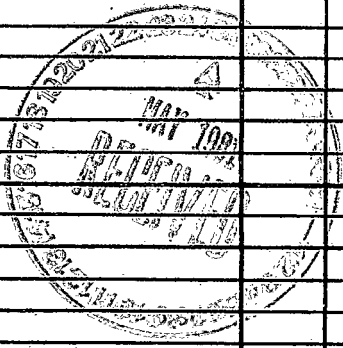

If well telescopes please sketch and show depths.

GROUND LEVEL

Billy Joe

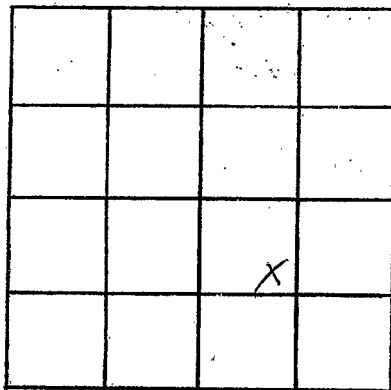

SECTION 30

Please indicate well location X.

ADDITIONAL INFORMATION

A series of horizontal lines for writing additional information, starting below the 'ADDITIONAL INFORMATION' header and extending to the bottom of the page.

If more than one screen, show locations of each on sketch.