

LEFLORE

SUNFLOWER
A80
5-14-80

MISSISSIPPI
BOARD OF WATER COMMISSIONERS
416 North State Street
Jackson, Mississippi 39201

CODED

WATER WELL DRILLERS LOG

LeFlore

~~Sunflower~~


5/14 1980
date well completed

Dyn
firm name

county well located

LANDOWNER:	description of formations encountered	from	to
GERALD CONWAY			
RENEVILLE MS. Minden (mailing address)	Clay Sand + Gravel	0	42
WELL LOCATION: sec. 25 T 22 N R 2 E S W			
4 miles (distance) N (direction) of Minden City (nearest town)			
WELL PURPOSE: <u>Drinking</u> (home, irrigation, municipal, industrial)			
WELL COMPLETION DATA:			
(1) diameter (inches) 16"			
(2) total depth (feet) 106'			
(3) static water level (feet) 20' below top of ground.			
(4) casing <u>Steel</u> (material), <u>106'</u> (depth) 16" (size) if telescope see back.			
(5) screen <u>40'</u> (length), <u>66'</u> (depth to top) 16" (size), <u>Steel</u> (material)			
(6) pump <u>60</u> (HP), <u>3000</u> (yield gpm) <u>Diesel</u> (type power)			
(7) electric log _____ (yes or no) (organization running log)			
(8) how well bottom plugged <u>plate</u>			
DRILLERS REMARKS:			

CODED

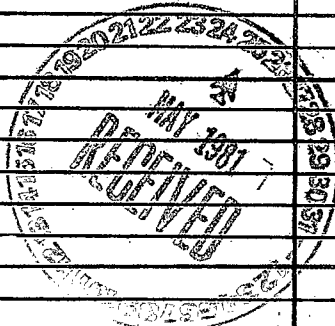

If well telescopes please sketch and show depths.

GROUND LEVEL

		2	
		X	

SECTION 25

Please indicate well location X.

ADDITIONAL INFORMATION

If more than one screen, show locations of each on sketch.