



If well telescopes please sketch and show depths.

GROUND LEVEL

Artic water Level 30'


16"

Casing

16"

Screen

40ft.

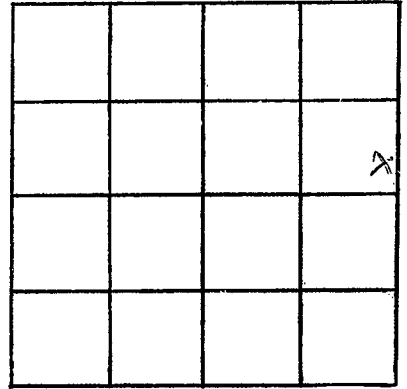

SECTION 9

Please indicate well location X.

ADDITIONAL INFORMATION

If more than one screen, show locations of each on sketch.