

LEFLORE
~~Lawson~~
A 82
6-15-81

MISSISSIPPI DEPARTMENT OF NATURAL RESOURCES
 Bureau of Land and Water Resources
 Southport Mall
 P.O. Box 10631
 Jackson, Mississippi 39209
WATER WELL DRILLERS LOG

CODED
 LeFlore

6/15/81 19 **Openwell & Dring** **Lawson**
 date well completed firm name county well located

LANDOWNER: The Cheers Farm description of formations encountered from to
Reeseville, Miss
 (mailing address) Clay 0 38
Sand 38 48
Sand & Gravel 48 100

WELL LOCATION:
 sec. 21 T 23 (N) R. 2 (E)
6 miles W of Winter city
 (distance) (direction) (nearest town)


WELL PURPOSE:
 (home, irrigation, municipal, industrial)

- WELL COMPLETION DATA:**
- (1) diameter (inches) 16
 - (2) total depth (feet) _____
 - (3) static water level (feet) 20 below above top of ground.
 - (4) casing Steel (material) (depth) _____
16 (size) If telescope see back.
 - (5) screen 40 (length) (depth to top) _____
16 (size) (material)
 - (6) pump 12 2000 (HP) (yield gpm)
Diesel (type power)
 - (7) electric log _____ (yes or no)

 (organization running log)
 (8) how well bottom plugged Partial


DRILLERS REMARKS:

CODED

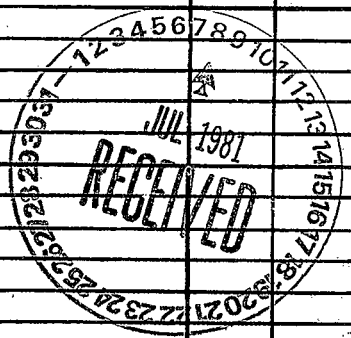

If well telescopes please sketch and show depths.

GROUND LEVEL

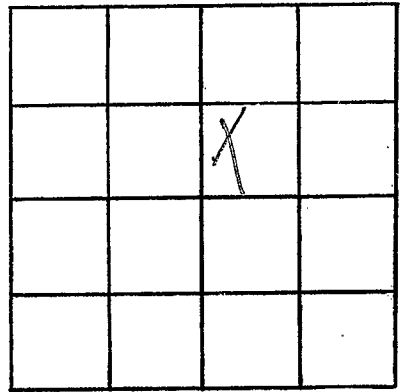

SECTION _____

Please indicate well location X.

ADDITIONAL INFORMATION

If more than one screen,
show locations of each on sketch.