

Leflore
A 83
4/11/81

MISSISSIPPI
 BOARD OF WATER COMMISSIONERS
 416 North State Street
 Jackson, Mississippi 39201

CODED

WATER WELL DRILLERS LOG

April 11 1981
 date well completed

Bruce Berryman
 firm name

LE FLORE
 county well located

Greenwood.

LANDOWNER: Mr. Hugh Arant

Rt. 1. Box 92

Ruleville. MS 38771

(mailing address)

WELL LOCATION:

sec. 30 T 22 N R 2 E
 S W
8 miles EE of Ruleville
 (distance) (direction) (nearest town)

WELL PURPOSE: Home

(home, irrigation, municipal, industrial)

WELL COMPLETION DATA:

(1) diameter (inches) 4" x 2"

(2) total depth (feet) 524 ft.

(3) static water level (feet) 21' below
 top of ground. 368' x

(4) casing 4" blk. - 126'
2" galy. - 378'
 (material) (depth)

 If telescope see back.
 (size)

(5) screen 20' , 504'
 (length) (depth to top)

.010 , Stainless steel
 (size) (material)

(6) pump 1 1/2 h.p. 35
 (HP) (yield gpm)

Electric
 (type power)

(7) electric log NO
 (yes or no)

 (organization running log)

(8) how well bottom plugged B.P.V

DRILLERS REMARKS:


description of formations
 encountered

from

to


Clay	0	20
Sand	20	60
Sand & Gravel	60	140
Clay	140	150
Sand	150	300
Clay	300	320
Sand	320	360
Shale	360	440
Sand	440	530
Shale	530	550

CODED

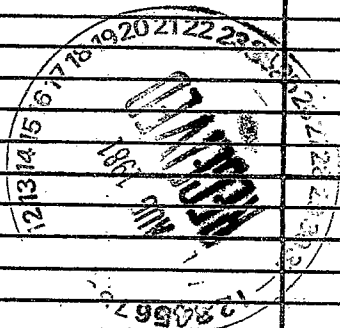

If well telescopes please sketch and show depths.

GROUND LEVEL

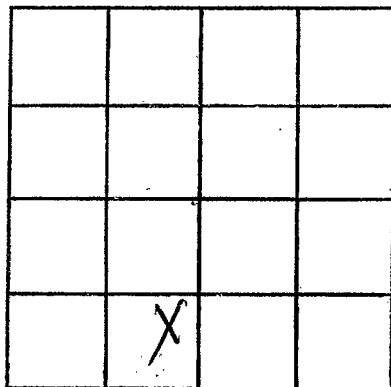

SECTION 30

Please indicate well location X.

ADDITIONAL INFORMATION

If more than one screen,
show locations of each on sketch.