

MISSISSIPPI DEPARTMENT OF NATURAL RESOURCES

Bureau of Land and Water Resources

Southport Mall

P.O. Box 10631

Jackson, Mississippi 39209

CODED₁₂

WATER WELL DRILLERS LOG


Leflore
A 84
8/19/81

8-19-81 19 DYERWELL & IRN LEFLORE
date well completed firm name county well located

LANDOWNER:	description of formations encountered	from	to
<u>Bill PALMONTRO</u> <u>Montic City, MS.</u> (mailing address)			
WELL LOCATION: sec. <u>33</u> T <u>22</u> (N) R. <u>2</u> (E) S <u>W</u> <u>5</u> miles <u>W</u> of <u>Montic City</u> (distance) (direction) (nearest town)	<u>Clay</u>	<u>0</u>	<u>18'</u>
WELL PURPOSE: (home, irrigation, municipal, industrial)	<u>find sand</u>	<u>18'</u>	<u>2 1/2'</u>
WELL COMPLETION DATA:	<u>Sand & Gravel</u>	<u>2 1/2'</u>	<u>103'</u>
(1) diameter (inches) <u>16"</u>	<p>DEPT. OF NATURAL RESOURCES BUREAU OF LAND & WATER RESOURCES</p> <p>AUG 26 1981</p> <p>RECEIVED</p>		
(2) total depth (feet) <u>103'</u>			
(3) static water level (feet) <u>22'</u> below above top of ground.			
(4) casing <u>Steel</u> , <u>63</u> , (material), (depth) <u>16"</u> If telescope see back. (size)			
(5) screen <u>40</u> , <u>63</u> (length) (depth to top)			
<u>16</u> , <u>Steel</u> (size) (material)			
(6) pump <u>60</u> <u>3000</u> (HP) (yield gpm)			
<u>Diesel</u> (type power)			
(7) electric log <u>no</u> (yes or no)			
(organization running log)			
(8) how well bottom plugged <u>plate</u>			
DRILLERS REMARKS:			

If well telescopes please sketch and show depths.

GROUND LEVEL

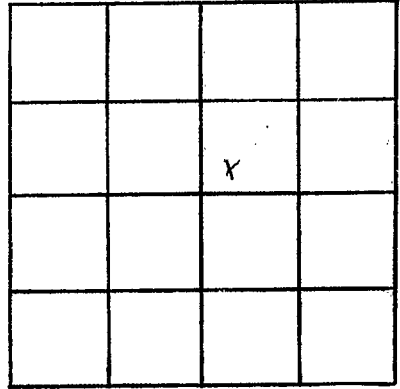

SECTION 33

Please indicate well location X.

ADDITIONAL INFORMATION

If more than one screen,
show locations of each on sketch.