

LEFLURE
A 85
7-12-82

MISSISSIPPI DEPARTMENT OF NATURAL RESOURCES
Bureau of Land and Water Resources
Southport Mall
P.O. Box 10631
Jackson, Mississippi 39209
WATER WELL DRILLERS LOG
BUTANE GAS COMPANY
OF GREENWOOD

LeFlure
LeFlure
county well located

7-12 1982
date well completed

LANDOWNER:
Eggen Plantation

(mailing address)

WELL LOCATION:
sec. B T 22 N R 4 West
2.5 miles NN of Winter City
(distance) (direction) (nearest town)

WELL PURPOSE: Domestic
(home, irrigation, municipal, industrial)

WELL COMPLETION DATA:
(1) diameter (inches) 69.5 x 2"
105 x 4"
(2) total depth (feet) 838
(3) static water level (feet) 8' ^{below} _{above} top of ground.
(4) casing Steel 798 (material) (depth) ?
69.5 x 2"
105 x 4" If telescope see back.
(size)
(5) screen 30' 798
30-4" (length) (depth to top)
10-2" 5-steel
(size) (material)

(6) pump 2 (HP) (yield gpm)
Electric (type power)
(7) electric log No (yes or no)
No (organization running log)

(8) how well bottom plugged Back Wash Valve

DRILLERS REMARKS:
Richard Vest

description of formations encountered	from	to
CLAY	0	20
fine sand	20	45
SAND	45	85
gravel	85	130
Rock	130	133
sand	133	160
Sand + Clay st.	160	221
white clay	221	265
Clay sand st.	265	323
Shale	323	370
Rock	370	372
sandy shale	372	453
Hard rock	453	455
Gummy shale	455	490
Sandy shale st.	490	505
sand shale st.	505	540
Gummy shale	540	670
Fine sand shale	670	715
Sand	715	730
shale	730	725
Fine sand + shale	725	795
Sand	795	845
Hard shale	845	923


DEPT. OF NATURAL RESOURCES
BUREAU OF LAND & WATER RESOURCES

AUG - 6 1982

RECEIVED

If well telescopes please sketch and show depths.

GROUND LEVEL

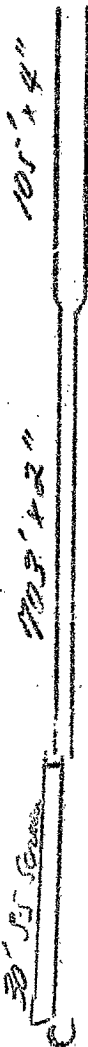

X			

SECTION 8

Please indicate well location X.

ADDITIONAL INFORMATION

If more than one screen, show locations of each on sketch.