

MISSISSIPPI DEPARTMENT OF NATURAL RESOURCES

Bureau of Land and Water Resources

Southport Mall

P.O. Box 10631

Jackson, Mississippi 39209

WATER WELL DRILLERS LOG

LEFLORE  
A 86

CODED

B-15  
date well completed

19 84

BUTANE GAS COMPANY

Leflore

GREENWOOD

county well located

LANDOWNER:  
A.E. Smith  
Minter city  
(mailing address)

description of formations encountered

from to

CLAY	0	25
SAND	25	55
SAND per gravel	55	85
gravel	85	105

WELL LOCATION:  
sec. 18 T. 22 N. R. 2 E  
S  
8.25 miles New of Minter city  
(distance) (direction) (nearest town)

CODED

WELL PURPOSE:  
(home, irrigation, municipal, industrial)

WELL COMPLETION DATA:

(1) diameter (inches) 16"

(2) total depth (feet) 105

(3) static water level (feet) 30 below above top of ground.

(4) casing Steel 65 (material), (depth)  
16" (size) if telescope see back.

(5) screen 40' 65 (length), (depth to top)  
16 (size), Steel (material)

(6) pump 40 1500 (HP) (yield gpm)  
PROPANE (type power)

(7) electric log No (yes or no)  
No (organization running log)

(8) how well bottom plugged  
Steel plate

DEPT. OF NATURAL RESOURCES  
BUREAU OF LAND & WATER RESOURCES


JUN 18 1984

RECEIVED

DRILLERS REMARKS:

If well telescopes please sketch and show depths.

GROUND LEVEL

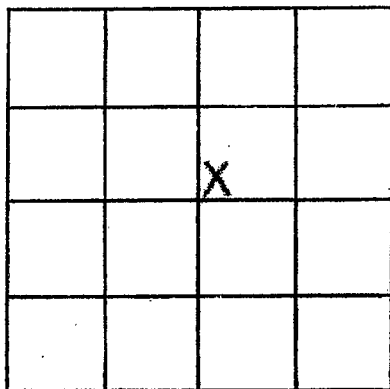

SECTION 22

Please indicate well location X.

ADDITIONAL INFORMATION

If more than one screen, show locations of each on sketch.