

MISSISSIPPI DEPARTMENT OF NATURAL RESOURCES

Bureau of Land and Water Resources

Southport Mall

P.O. Box 10631

Jackson, Mississippi 39209

WATER WELL DRILLERS LOG

BUTANE GAS COMPANY

OF GREENWOOD

Leflore
county well located

LEFLORE
A 87

6-14 1984
date well completed

LANDOWNER:
A. E. Smith
Minter city
(mailing address)

description of formations encountered

from to

clay 0 18
sand 18 50
gravel 50 105

WELL LOCATION:

sec. 18 T. 22 N. R. 2 E.
S. W.
8 miles NW of Minter city
(distance) (direction) (nearest town)

CODED

WELL PURPOSE:

(home, irrigation, municipal, industrial)

WELL COMPLETION DATA:

- (1) diameter (inches) 16"
- (2) total depth (feet) 105
- (3) static water level (feet) 30 ^{below} _{above} top of ground.
- (4) casing steel, 65'
(material), (depth)
16" if telescope see back.
(size)
- (5) screen 40', 65'
(length), (depth to top)
16, steel
(size), (material)
- (6) pump 40 1500
(HP), (yield gpm)
Propex
(type power)
- (7) electric log No
(yes or no)
No
(organization running log)

(8) how well bottom plugged steel plate

DRILLERS REMARKS:


DEPT. OF NATURAL RESOURCES
BUREAU OF LAND & WATER RESOURCES

JUN 18 1984

RECEIVED

If well telescopes please sketch and show depths.

GROUND LEVEL

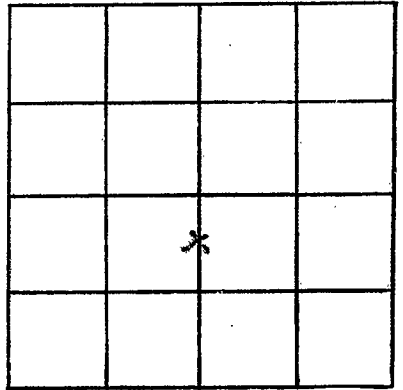

SECTION 22

Please indicate well location X.

ADDITIONAL INFORMATION

If more than one screen, show locations of each on sketch.