

MISSISSIPPI DEPARTMENT OF NATURAL RESOURCES

Bureau of Land and Water Resources

Southport Mall

P.O. Box 10631

Jackson, Mississippi 39209

WATER WELL DRILLERS LOG

CODED

LEFLORE
A90

7-19
date well completed

36 BUTANE GAS COMPANY
OF GREENWOOD

Leflore
county well located

LANDOWNER:
E. B. Smith, Jr.
Winter City
(mailing address)

description of formations encountered	from	to
<u>CLAY</u>	<u>0</u>	<u>28</u>
<u>FINE SAND</u>	<u>28</u>	<u>55</u>
<u>SAND & pea gravel</u>	<u>55</u>	<u>85</u>
<u>Gravel</u>	<u>85</u>	<u>103</u>

WELL LOCATION:
sec. 28 T 22 N R 2 W
5.5 miles W of Winter City
(distance) (direction) (nearest town)

WELL PURPOSE: TR
(home, irrigation, municipal, industrial)

- WELL COMPLETION DATA:
- (1) diameter (inches) 16"
 - (2) total depth (feet) 103
 - (3) static water level (feet) 20 ^{below} above top of ground.
 - (4) casing Steel, 63,
(material) (depth)
16" If telescope see back.
(size)
 - (5) screen 40, 63
(length) (depth to top)
16" Steel
(size) (material)
 - (6) pump 40 2000
(HP) (yield gpm)
Diesel
(type power)
 - (7) electric log No
(yes or no)
- (organization running log)

(8) how well bottom plugged
Steel casing


DRILLERS REMARKS:

CODED

RECEIVED
AUG 12 1986
Department of Natural Resources
Bureau of Land & Water Resources

If well telescopes please sketch and show depths.

GROUND LEVEL

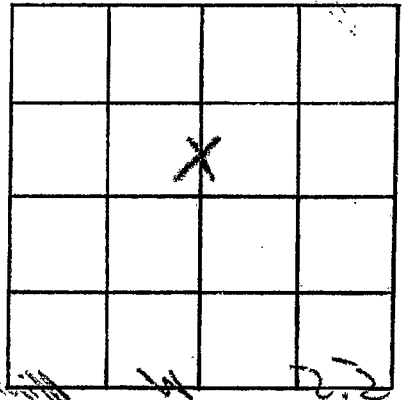

SECTION 28

Please indicate well location X.

ADDITIONAL INFORMATION

If more than one screen, show locations of each on sketch.