

MISSISSIPPI DEPARTMENT OF NATURAL RESOURCES

Bureau of Land and Water Resources

Southport Mall

P.O. Box 10631

Jackson, Mississippi 39209

WATER WELL DRILLERS LOG

CODED

LEFLORE

T.E.P A 91

06792-CMG-04-18-87

3-11 1987 Dyer Well Inc Leflore  
 date well completed firm name county well located

LANDOWNER: M.C. Tellman  
 Minter City, Ms 38944

(mailing address)

WELL LOCATION:

sec. 36 T. 22 N R. 2 E  
 S W Schlater  
 miles of (distance) (direction) (nearest town)

WELL PURPOSE: Irrigation  
 (home, irrigation, municipal, industrial)

WELL COMPLETION DATA:

- (1) diameter (inches) 16"
- (2) total depth (feet) 105
- (3) static water level (feet) \_\_\_\_\_ below above top of ground.
- (4) casing Steel (material), (depth) 16" (size) if telescope see back.
- (5) screen 40' (length), (depth to top) 16" (size), Mild Steel (material)
- (6) pump 1/2 (HP) 1800 (yield gpm) Diesel (type power)
- (7) electric log NO (yes or no)
- (8) how well bottom plugged Plate

description of formations encountered	from to	
	feet	feet
Clay	0	28
Silt sand	28	40
Sand	40	50
Sand & Gravel	50	105

CODED

RECEIVED

MAR 18 1987

Department of Natural Resources  
 Bureau of Land & Water Resources


DRILLERS REMARKS:

T.E.P

06792-CMG-04-18-87

If well telescopes please sketch and show depths.

GROUND LEVEL

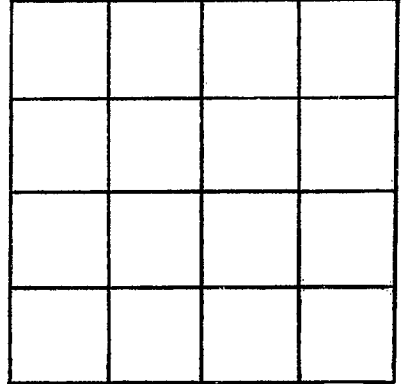

SECTION \_\_\_\_\_

Please indicate well location X.

ADDITIONAL INFORMATION

If more than one screen, show locations of each on sketch.