

MISSISSIPPI DEPARTMENT OF NATURAL RESOURCES

Bureau of Land and Water Resources

Southport Mall

P.O. Box 10631

Jackson, Mississippi 39209

WATER WELL DRILLERS LOG

LeFlora
A 93
108 D

Coded

4-9 1987 J & K IRRIGATION LeFlora
 date well completed firm name county well located

LANDOWNER: Elizabeth Bower
404 E Jeff Davis St.
Greenwood, Miss 38930
 (mailing address)


description of formations encountered	from	to
Clay	0	16
Fine Sand	16	37
Coarse Sand & Gravel	37	114

WELL LOCATION:
 NW 14 SE 14 T 22 N R 2 W
6 miles NW of Mitler City
 (distance) (direction) (nearest town)

WELL PURPOSE: IRRIGATION
 (home, irrigation, municipal, industrial)

WELL COMPLETION DATA:

(1) diameter (inches) 16"
 (2) total depth (feet) 114'
 (3) static water level (feet) 24 below above top of ground.
 (4) casing Steel 84
 (material) (depth)
16" if telescope see back.
 (size)
 (5) screen 40' 84
 (length) (depth to top)
16 Steel
 (size) (material)
 (6) pump 50 3000
 (HP) (yield gpm)
Diesel
 (type power)
 (7) electric log NO
 (yes or no)

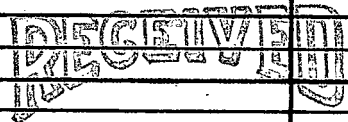

NOV 12 1987


Department of Natural Resources
 Bureau of Land & Water Resources

(organization running log)
 (8) how well bottom plugged R/I/A/T/E

DRILLERS REMARKS:

If well telescopes please sketch and show depths.

GROUND LEVEL

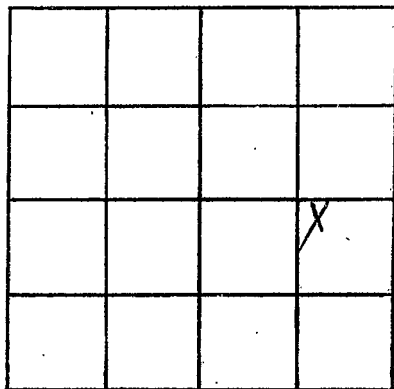

SECTION 14

Please indicate well location X.

ADDITIONAL INFORMATION

If more than one screen,
show locations of each on sketch.