

COUNTY WELL LOCATED  
*LeFlore*

WELL NUMBER  
*A-96*

DATE WELL COMPLETED  
*7-14-88*

**RECORDED**

MISSISSIPPI DEPARTMENT OF NATURAL RESOURCES  
Bureau of Land and Water Resources

PERMIT NUMBER  
*1161-CMG-092088*

NAME OF DRILLING FIRM  
**BUTANE GAS CO. OF GREENWOOD**

P.O. Box 10631  
Jackson, Mississippi 39209  
WATER WELL DRILLERS LOG

NAME & MAILING ADDRESS OF LANDOWNER  
*Frank T. Leavell*  
*Winter City, Miss.*

WELL LOCATION: SEC *17* TOWNSHIP *22* RANGE *2*  
*NE 1/4 SW* *N* *W*

DISTANCE *6* Miles *NW* DIRECTION of *Winter City* NEAREST TOWN

OTHER LANDMARK

WELL PURPOSE: Home, Irrigation, Municipal, Industrial, Fish Pond, etc.  
*Irrigation*

**PUMP DATA**

PUMP TYPE (Circle One):  
Submersible, Turbine, Jet, Flowing Well,  
Other (Describe) \_\_\_\_\_

POWER TYPE (Circle One):  
Electric, Tractor, Diesel, Gasoline, Butane,  
Other (Describe) \_\_\_\_\_ H/P *40*

Pump Capacity (GPM) <i>1800</i>	No. of Stages <i>2</i>	Setting Depth <i>60</i> FT.
------------------------------------	---------------------------	--------------------------------

PUMP TEST

Well yielded \_\_\_\_\_ GPM with  
a drawdown of \_\_\_\_\_ ft.  
after \_\_\_\_\_ hours of pumping

**WELL DATA**

Well Depth <i>105</i>	Casing Diameter (In.) <i>16</i>	Casing Length (Ft.) <i>65</i>
Type of Casing <i>Steel</i>	Hole Depth <i>105</i>	Depth to Static Water Level <i>25</i>

TYPE OF COMPLETION: (Circle One or More):  
Gravel Packed, Underreamed, Telescoped,  
Natural Development, Open Hole, Other

Top of Lap Pipe or Reduction in Casing  
FEET IF TELESCOPED OR MORE THAN ONE SCREEN: USE BACK PAGE

**LOG DATA**

TYPE OF LOG RUN (Circle One): No Log Run,  
Electric, Gamma Ray, Density, Sonic, Neutron,  
Other (Describe) \_\_\_\_\_

Name of Organization Running Log

**SCREEN DATA**

Diameter - Inches <i>16</i>	Length - Feet <i>40</i>	Slot Size - Inches <i>.030</i>
Screen Type <i>Wire Wrapped</i>	Depth to Bottom - Feet <i>105</i>	

**GEOLOGIC DATA (Office Use Only)**

Surface Elev.	Geologic Unit	Unit Thickness	Depth to Top
Subs. SWL	Date	Analysis	Aquifer Test

Driller's Remarks

DESCRIPTION OF FORMATIONS ENCOUNTERED	FROM	TO
<i>CLAY</i>	<i>0</i>	<i>40</i>
<i>SAND</i>	<i>40</i>	<i>60</i>
<i>SAND &amp; GRAVEL</i>	<i>60</i>	<i>105</i>

FORMATIONS (Continued)

FROM	TO

**RECEIVED**


**AUG 02 1988**

Department of Natural Resources  
Bureau of Land & Water Resources

IF MORE SPACE IS NEEDED, USE BACK

If well telescopes please sketch and show depths.

GROUND LEVEL

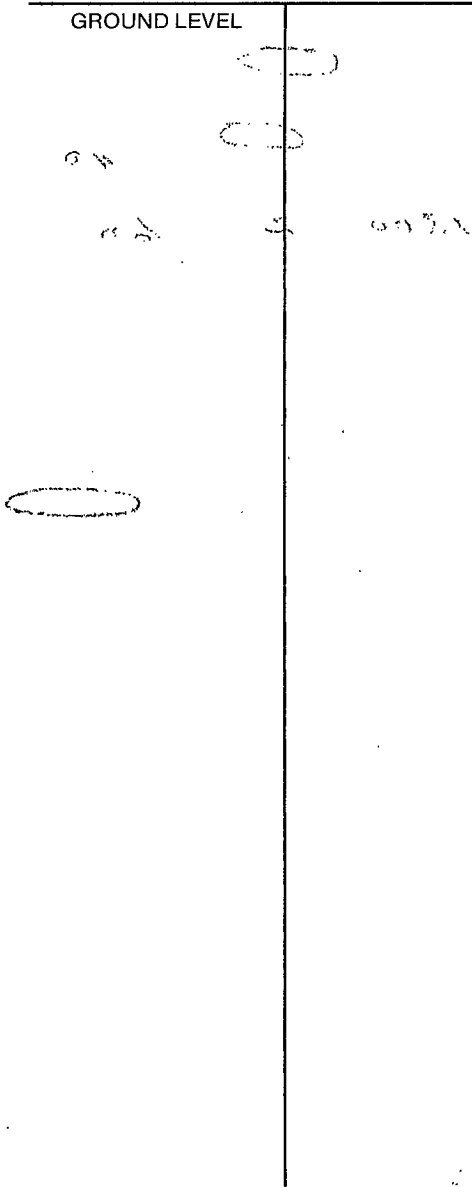

100	100	100	100
	X		

SECTION 17

Please indicate well location X.

ADDITIONAL INFORMATION

Handwritten notes and a circled mark on the additional information lines.

If more than one screen, show location of each on sketch.