

**MISSISSIPPI DEPARTMENT OF ENVIRONMENTAL  
QUALITY**

Office of Land and Water Resources

COUNTY WELL LOCATED Leflore	
WELL NUMBER A-108	CODED
DATE WELL COMPLETED 5-3-01	

PERMIT NUMBER
NAME OF DRILLING FIRM Irrigation Equipment Inc.
Indianola, MS

P. O. Box 10631  
Jackson, MS 39289-0631  
**WATER WELL DRILLERS LOG**

NAME & MAILING ADDRESS OF LANDOWNER Capital AG Services 1704 Walker Lane, Suite 5 Greenville, MS 38701			
Latitude: Longitude:			
WELL LOCATION	SEC	TOWNSHIP	RANGE
sw/se	25	22N S	2W W
DISTANCE	DIRECTION	NEAREST TOWN	
Miles	SW	Minter City	
OTHER LANDMARK			
WELL PURPOSE: Home, Irrigation, Municipal, Industrial, Fish Pond, etc. Irrigation			

<b>PUMP DATA</b>		
PUMP TYPE (Circle One): Submersible, <u>Turbine</u> , Jet, Flowing Well, Other (Describe) _____		
POWER TYPE (Circle One): Electric, Tractor, <u>Diesel</u> , Gasoline, Butane, Other (Describe) _____	H/P	60

DESCRIPTION OF FORMATIONS ENCOUNTERED	FROM	TO
Clay	0	38
Fine Sand/gravel	38	45
Med. Sand/gravel	45	58
Fine Sand/gravel	58	65
Med. Sand/gravel	65	115

<b>WELL DATA</b>		
Well Depth 115	Casing Diameter (In.) 16	Casing Length (Ft.) 75
Type of Casing pvc	Hole Depth 115	Depth to Static Water Level 37ft.
TYPE OF COMPLETION: (Circle One or More): <u>Gravel Packed</u> , Underreamed, Telescoped, Natural Development, Open Hole, Other (Describe) _____		

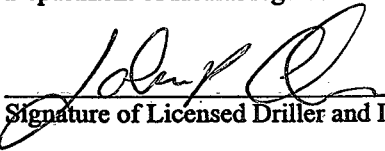
WELL GROUTED TO A DEPTH OF _____ FEET
Type Grout (circle one): Cement, Bentonite, or Mix

RECD SEP 10 2001

<b>SCREEN DATA</b>		
Diameter - Inches 16	Length - Feet 40	Slot Size - Inches .050
Screen Type pvc	Depth to Bottom - Feet 115	

Top of Lap Pipe or Reduction in Casing	FEET	IF TELESCOPED OR MORE THAN ONE SCREEN: USE BACK PAGE
--	------	--

I certify that the well was drilled, constructed and completed in accordance with all applicable Requirements of the Mississippi Department of Environmental Quality and/or the Mississippi Department of Health regulations and state laws.


0-439
9-6-01  
 Signature of Licensed Driller and License No. Date

Additional Information Required On Back

If well telescopes please sketch and show depths.

GROUND LEVEL

		X	

25

SECTION \_\_\_\_\_

Please indicate well location X.

Pump Capacity (GPM)	No. of Stages	Setting Depth
2500	2	70 FT.

PUMP TEST

Well yielded \_\_\_\_\_ GPM with  
a drawdown of \_\_\_\_\_ ft.  
after \_\_\_\_\_ hours of pumping

**LOG DATA**

TYPE OF LOG RUN (Circle One):      No Log Run,  
Electric, Gamma Ray, Density, Sonic, Neutron,  
Other (Describe) \_\_\_\_\_

Name of Organization Running Log

**GEOLOGIC DATA (Office Use Only)**

Surface Elev.	Geologic Unit	Unit Thickness	Depth to Top
Subs. SWL	Date	Analysis	Aquifer Test

Driller's Remarks

---



---



If more than one screen,  
show location of each on sketch.