

State Well Report

Part 1

Mississippi Department of Environmental Quality
Office of Land and Water Resources
P.O. Box 10631
Jackson, MS 39289-0631
(601)961-5210
(601)354-6938 (fax)

For Office Use Only:

Aquifer: _____
Well #: A-136
L. S. Elevation: _____
E-log #: _____

County: Leflore
Permit #: _____
Irrigation Equipment
Driller: _____
Date drilling completed: 4-7-07

State Law requires that this report be prepared by the driller in detail and filed with the Department within 30 days of completion of drilling of the well.

Well Owner Information		Well Location	
Owner Name: <u>Karl Gossel</u>		Latitude: <u>33° 45' 13.2"</u>	Longitude: <u>90° 23' 45.5"</u>
Mailing Address: <u>21300 East 1100 street</u>		Method of Lat/Long (circle one): <u>46</u> Conventional Survey, <u>13</u> <u>45</u>	
<u>Good Hope IL 61438</u>		USGS quad, Hand-held GPS, Survey-grade GPS	
City State Zip Code		<u>NE</u> 1/4 <u>SW</u> 1/4 Sec <u>15</u> Twn <u>22N</u> Rng <u>2W</u>	
Telephone No. () _____		Distance Direction Nearest Town <u>6</u> Miles <u>West</u> of <u>Minter city</u>	

Well Data	
Purpose of Well (circle one) Home Industrial Public Supply <u>Irrigation</u> Fish Culture Other: _____	
Date well drilling started: <u>4-7-07</u>	Date well drilling completed: <u>4-7-07</u>
If flowing, method of flow regulation: Valve _____ Other (describe) _____	
Static Water Level: <u>44</u> feet above or <u>below</u> (circle one) land surface	Date measured: <u>4-7-07</u>
Method of Measurement (circle one) <u>steel tape</u> electric tape air line other: _____	
Hole depth: <u>125</u> Well depth: <u>125</u> Well grouted to a depth of <u>10</u> feet	
Type of grout (circle one) Cement <u>Bentonite</u> Mix	
Casing length: <u>85</u> feet Casing diameter: <u>16</u> inches	Type of casing: <u>PVC sch 40</u>
Screen length: <u>40</u> feet Screen diameter: <u>16</u> inches	Type of screen: <u>PVC sch 40</u>
Screen slot size: <u>.050</u> inches	Setting depth: From <u>85</u> feet to <u>125</u> feet
Type of completion (circle all applicable): <u>Gravel packed</u> Underreamed Telescoped Open hole Natural Development	
Other (describe): _____	
Top of lap pipe or reduction in casing: _____ feet. If telescoped or more than one screen, describe on back of page	
Logs run (circle all applicable): <u>No log run</u> Electric Gamma Ray Density Sonic Neutron Other: _____	
Name of organization running log(s): _____	

I certify that the well was drilled, constructed, and completed in accordance with all applicable requirements of the Mississippi Department of Environmental Quality and/or the Mississippi Department of Health regulations and state laws.

Irrigation Equipment Inc.
Patrick M. Chism 0695

Patrick M Chism

Print Name of Water Well Contractor and License No.

Signature of Water Well Contractor

RECEIVED
MAY 07 2007
BY: OLWR

A-


If well telescopes please sketch below and show depths.

Ground Level

Description of Formations Encountered	From	To
Clay	0	29
Fine sand	30	35
Fine sand + gravel	36	49
med. sand + gravel	50	125

If more than one screen, show location of each on sketch

Sketch the property layout and include the following: 1) the well location; 2) any permanent structures on the property that may aid in locating the well; 3) any roads, power lines, or other items that may aid in locating the property and the well; 4) indicate direction.

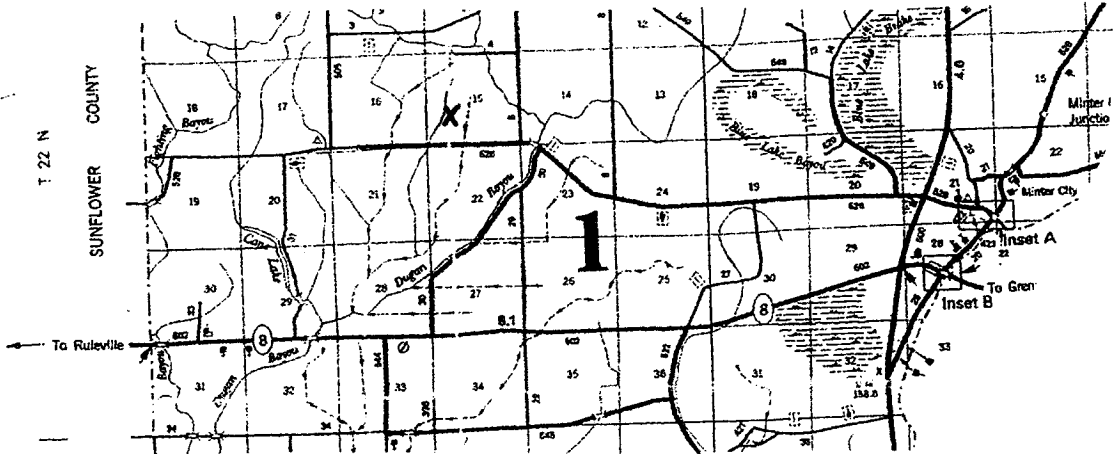

Landowner Name: _____

Pat MCO
Signature of Water Well Contractor

STATE WELL REPORT

Part 2

Pump Installer's Completion Report
 Mississippi Department of Environmental Quality
 Office of Land and Water Resources
 P.O. Box 10631
 Jackson, MS 39289-0631
 (601)961-5210
 (601)354-6938 (fax)

County: Leflore
 Permit #: _____
 Irrigation Equipment
 Driller: _____
 Date completed: 4-7-07

For Office Use Only:

Aquifer: _____
 Well #: A-136
 Elevation: _____

This report should be prepared by the pump installer in detail and filed with the Department within 30 days of the installation of pump.

Well Owner Information	Well Location
Owner Name: <u>Karl Gosbel</u> Mailing Address: <u>21300 East 1100 street</u> <u>Good Hope IL 61438</u> City State Zip Code Telephone No. () _____	Latitude: _____ Longitude: _____ Method of Lat/Long (circle one): Conventional Survey, USGS quad, Hand-held GPS, Survey-grade GPS <u>NW 1/4 SW 1/4 Sec 15 Twn 22N Rng 2W</u> Distance Direction Nearest Town <u>6 Miles West of Minter City</u>

Pump Type Circle one	Power Type Circle one
Air Lift Jet Submersible Bucket Piston <u>Turbine</u> Centrifugal Rotary Flowing Well Other (specify): _____ Date Pump Installed: <u>4-7-07</u> Rated Pump Capacity: <u>2800 ±</u> Gallons Per Minute	<u>Diesel Engine</u> Gasoline Engine Natural Gas Electric Motor Hand Tractor PTO Windmill Other (specify): _____ Horse Power Rating of Motor: <u>60</u> Setting Depth: <u>70</u> feet Number of Stages: <u>1</u>

Pump Test Data	Method of Measuring Water Level Circle one
Date Well Tested: _____ Static Water Level (A): _____ Feet Below Land Surface Pumping Water Level (B): _____ Feet Below Land Surface Drawdown [(B) - (A)]: _____ Feet Below Land Surface Test Pumping Rate: _____ Gallons Per Minute Duration of Pump Test (minimum 4 hours): _____ hours	Air Line Electric Measuring Line Steel Tape Other (specify): _____ For flowing well, measured shut in head: _____ feet Well yielded _____ GPM with a drawdown of _____ feet after _____ hours of pumping

I HEREBY CERTIFY that the above statements are true to the best of my knowledge.

Patrick M. Chism 0695 Patrick M. Chism
 Print Name of Pump Installer and License No. (if applicable) Signature of Pump Installer

RECEIVED
 MAY 07 2007
 BY: OLWR