

State Well Report

Part 1

Mississippi Department of Environmental Quality
Office of Land and Water Resources
P.O. Box 10631
Jackson, MS 39289-0631
(601)961-5210
(601)354-6938 (fax)

County: Leflore
Permit #: GW42494
Irrigation Equipment
Driller:
Date drilling completed: 4-22-08

For Office Use Only:
Aquifer:
Well #: A-142
L. S. Elevation:
E-log #:

State Law requires that this report be prepared by the driller in detail and filed with the Department within 30 days of completion of drilling of the well.

| Well Owner Information | | Well Location | |
|------------------------------------|--|---|--|
| Owner Name: <u>Jimmy Chandler</u> | | Latitude: <u>33.44.22.7</u> | Longitude: <u>90.23.74.4</u> |
| Mailing Address: <u>1185 Hwy 8</u> | | Method of Lat/Long (circle one): <u>Conventional Survey</u> | |
| <u>Ruleville Ms. 38771</u> | | USGS quad, Hand-held GPS, Survey-grade GPS | |
| City State Zip Code | | <u>NE 1/4 NW 1/4 Sec 34 Twn 22N Rng 2W</u> | |
| Telephone No. () | | Distance: <u>6</u> Miles | Direction: <u>SW</u> of Nearest Town: <u>Minter City</u> |

Well Data

Purpose of Well (circle one) Home Industrial Public Supply Irrigation Fish Culture Other: _____

Date well drilling started: 4-22-08 Date well drilling completed: 4-22-08

If flowing, method of flow regulation: Valve _____ Other (describe) _____

Static Water Level: 40 feet above or below (circle one) land surface Date measured: 5-12-08

Method of Measurement (circle one) steel tape electric tape air line other: _____

Hole depth: 122 Well depth: 122 Well grouted to a depth of 10 feet

Type of grout (circle one): Cement Bentonite Mix

Casing length: 82 feet Casing diameter: 16 inches Type of casing: PVC

Screen length: 40 feet Screen diameter: 16 inches Type of screen: PVC

Screen slot size: .050 inches Setting depth: From 83 feet to 122 feet

Type of completion (circle all applicable): Gravel packed Underreamed Telescoped Open hole Natural Development

Other (describe): _____

Top of lap pipe or reduction in casing: _____ feet. If telescoped or more than one screen, describe on back of page

Logs run (circle all applicable): No log run Electric Gamma Ray Density Sonic Neutron Other: _____

Name of organization running log(s): _____

I certify that the well was drilled, constructed, and completed in accordance with all applicable requirements of the Mississippi Department of Environmental Quality and/or the Mississippi Department of Health regulations and state laws.

Irrigation Equipment Inc
Patrick M. Chism 0695

Print Name of Water Well Contractor and License No. _____ Signature of Water Well Contractor Patrick M. Chism

RECEIVED
MAY 15 2008
BY: OLWR

A-142

If well telescopes please sketch below and show depths.

Ground Level

| Description of Formations Encountered | From | To |
|---------------------------------------|------|-----|
| Clay | 0 | 37 |
| Course Sand | 38 | 48 |
| Course Sand + Gravel | 49 | 122 |
| | | |
| | | |
If more than one screen, show location of each on sketch

Sketch the property layout and include the following: 1) the well location; 2) any permanent structures on the property that may aid in locating the well; 3) any roads, power lines, or other items that may aid in locating the property and the well; 4) indicate direction.

Landowner Name: Jimmy Chandler

[Signature]
Signature of Water Well Contractor

RECEIVED
MAY 15 2008
BY: OLWR

STATE WELL REPORT

Part 2

Pump Installer's Completion Report
 Mississippi Department of Environmental Quality
 Office of Land and Water Resources
 P.O. Box 10631
 Jackson, MS 39289-0631
 (601)961-5210
 (601)354-6938 (fax)

County: Leflore
 Permit #: _____
 Irrigation Equipment
 Driller: _____
 Date completed: 4-22-08

For Office Use Only:

Aquifer: _____
 Well #: A-142
 Elevation: _____

This report should be prepared by the pump installer in detail and filed with the Department within 30 days of the installation of pump.


| Well Owner Information | Well Location |
|--|---|
| Owner Name: <u>Jimmy Chandler</u> | Latitude: _____ Longitude: _____ |
| Mailing Address: <u>1183 Hwy 8</u> | Method of Lat/Long (circle one): Conventional Survey, USGS quad, Hand-held GPS, Survey-grade GPS |
| <u>Ruleville</u> <u>Ms.</u> <u>38771</u> | <u>NE</u> 1/4 <u>NW</u> 1/4 Sec <u>34</u> Twn <u>22N</u> Rng <u>2W</u> |
| City State Zip Code | NW Distance Direction Nearest Town |
| Telephone No. () _____ | <u>6</u> Miles <u>SW</u> of <u>Minter City</u> |

| Pump Type Circle one | Power Type Circle one |
|--|---|
| Air Lift Jet Submersible | Diesel Engine Gasoline Engine Natural Gas |
| Bucket Piston <u>Turbine</u> | <u>Electric Motor</u> Hand Tractor PTO |
| Centrifugal Rotary Flowing Well | Windmill Other (specify): _____ |
| Other (specify): _____ | Horse Power Rating of Motor: <u>60</u> |
| Date Pump Installed: <u>5-12-08</u> | Setting Depth: <u>70</u> feet |
| Rated Pump Capacity: <u>2300±</u> Gallons Per Minute | Number of Stages: <u>2</u> |

| Pump Test Data | Method of Measuring Water Level Circle one |
|--|---|
| Date Well Tested: _____ | Air Line Electric Measuring Line Steel Tape |
| Static Water Level (A): _____ Feet Below Land Surface | Other (specify): _____ |
| Pumping Water Level (B): _____ Feet Below Land Surface | For flowing well, measured shut in head: _____ feet |
| Drawdown [(B) - (A)]: _____ Feet Below Land Surface | Well yielded _____ GPM with a drawdown of _____ feet after _____ hours of pumping |
| Test Pumping Rate: _____ Gallons Per Minute | |
| Duration of Pump Test (minimum 4 hours): _____ hours | |

I HEREBY CERTIFY that the above statements are true to the best of my knowledge.

Patrick M. Chism 0695
 Print Name of Pump Installer and License No. (if applicable)

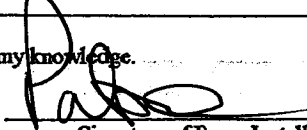
 Signature of Pump Installer

RECEIVED

MAY 15 2008
 BY: OLWR

R 2 W


R 1 W

R 1 E

TALLAHATCHIE COUNTY

TALLAHATCHIE COU

Jimmy Chandler Map

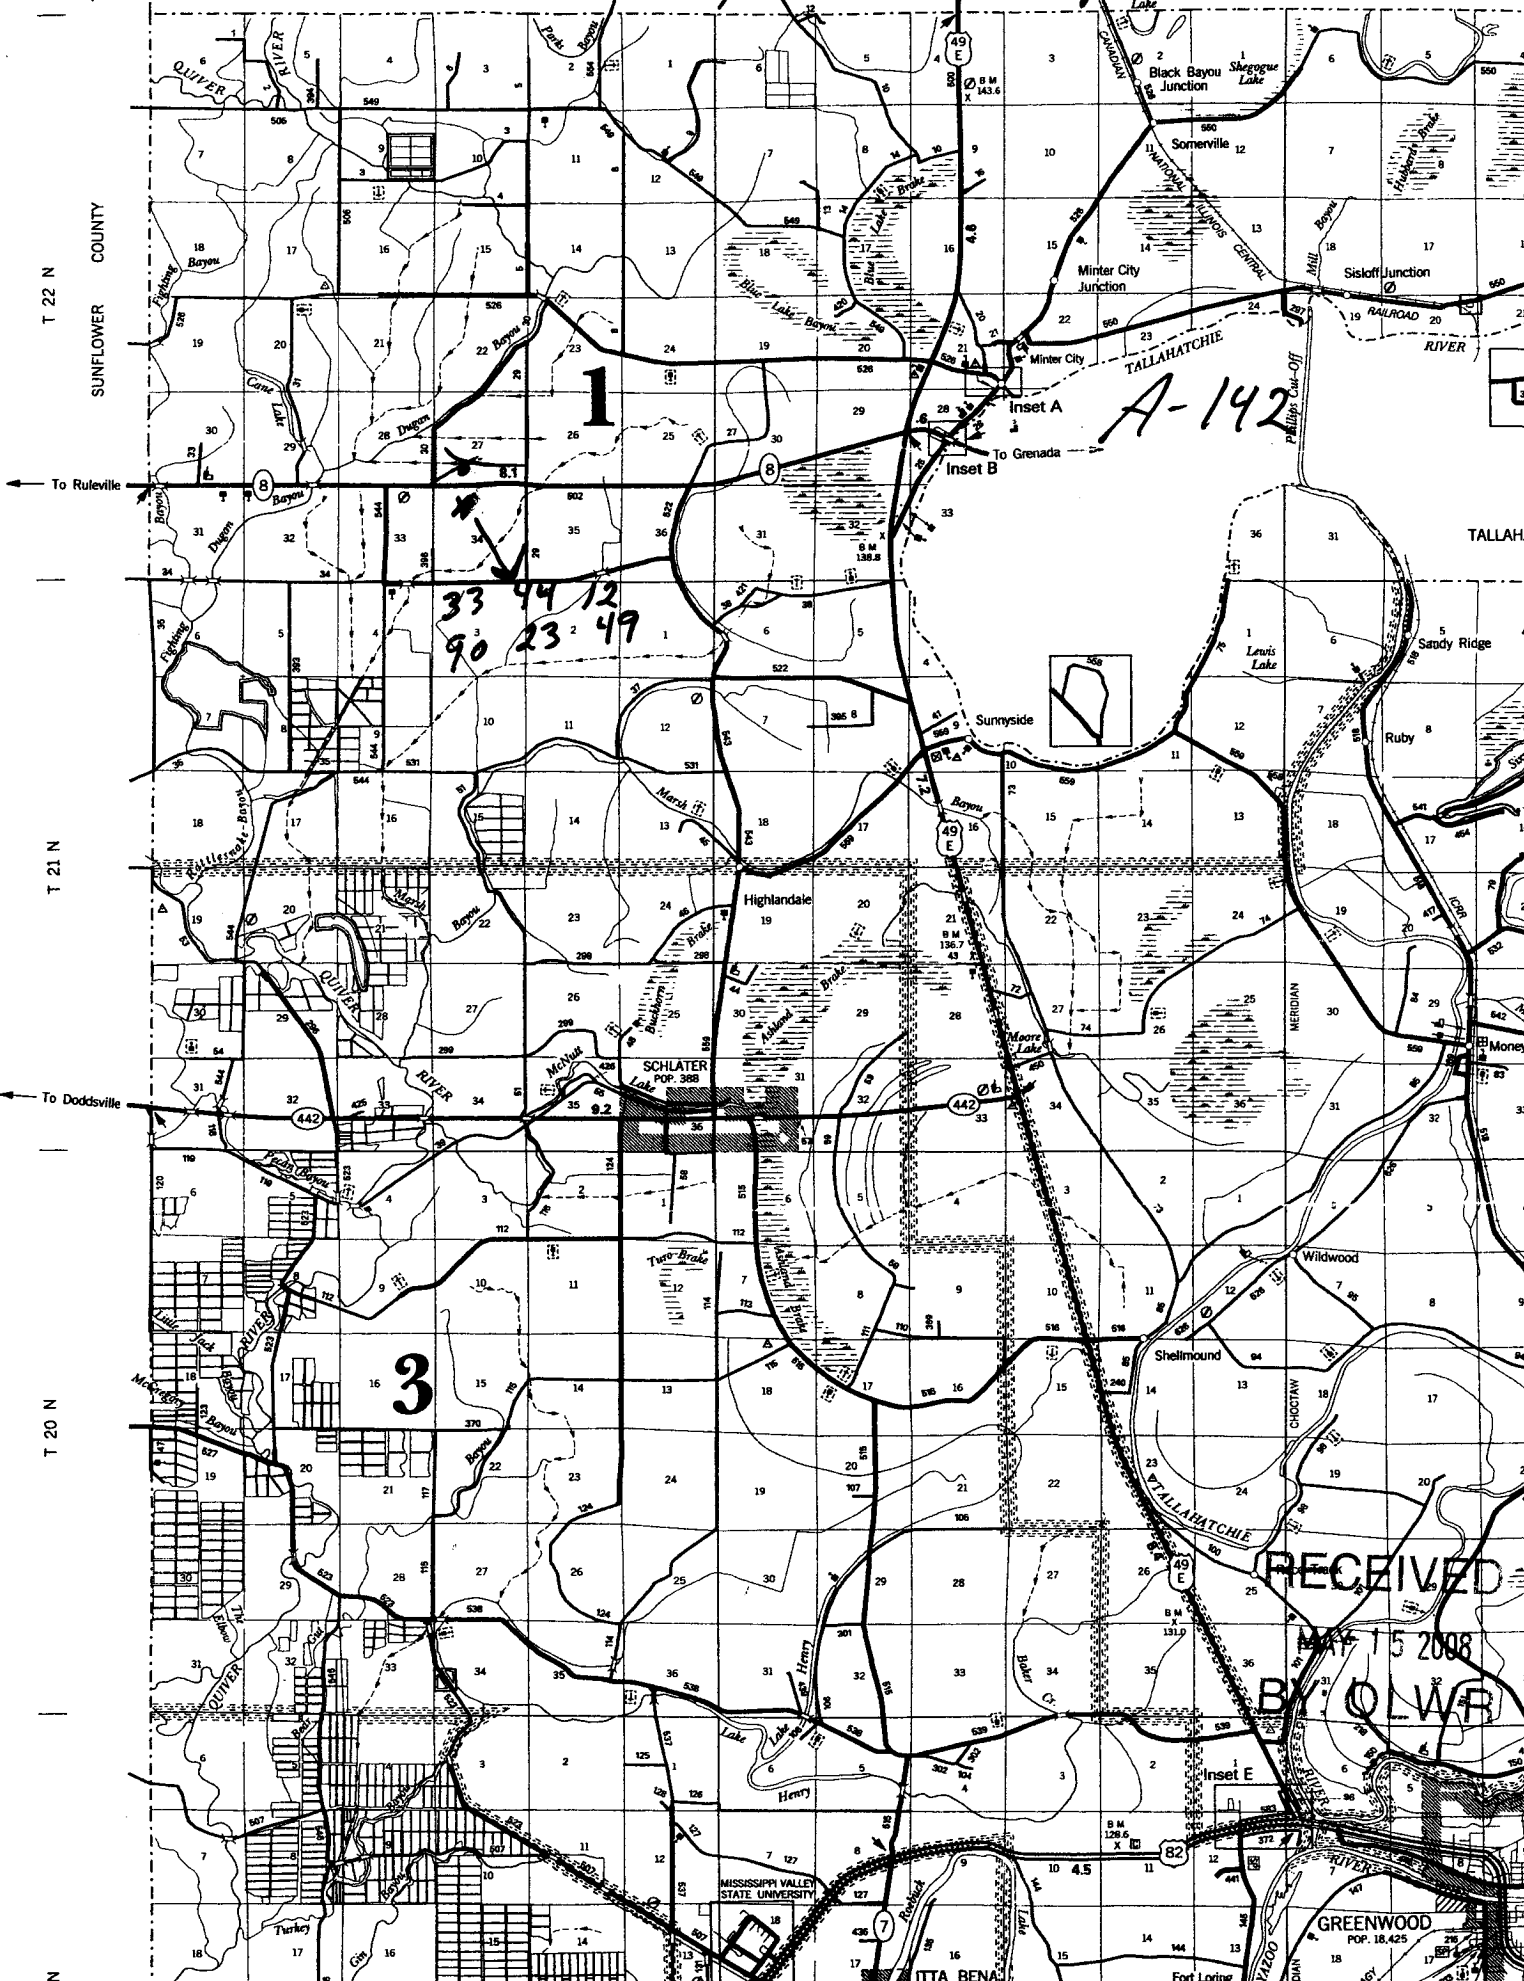

RECEIVED
 MAY 15 2008
 BY OWR

MISSISSIPPI VALLEY STATE UNIVERSITY

GREENWOOD
 POP. 18,425