

State Well Report

Part 1

Mississippi Department of Environmental Quality
Office of Land and Water Resources
P.O. Box 10631
Jackson, MS 39289-0631
(601)961-5210
(601)354-6938 (fax)

County: Leflore
Permit #: _____
Irrigation Equipment
Driller: _____
Date drilling completed: 6-16-09

For Office Use Only:
Aquifer: _____
Well #: A149
L. S. Elevation: _____
E-log #: _____

State Law requires that this report be prepared by the driller in detail and filed with the Department within 30 days of completion of drilling of the well.

Well Owner Information	Well Location
Owner Name: <u>Collier Tillman</u>	Latitude: <u>33° 43' 33"</u> Longitude: <u>90° 21' 22"</u>
Mailing Address: <u>P.O. Box 205</u>	Method of Lat/Long (circle one): Conventional Survey, USGS quad, Hand-held GPS, Survey-grade GPS
<u>Schlater Ms. 38952</u> City State Zip Code	<u>SW 1/4 SE 1/4 Sec 36 Twn 22N Rng 2W</u>
Telephone No. <u>(662) 658-0087</u>	Distance Direction Nearest Town <u>4</u> Miles <u>SW</u> of <u>Minter City</u>

Well Data

Purpose of Well (circle one) Home Industrial Public Supply Irrigation Fish Culture Other: _____

Date well drilling started: 6-16-09 Date well drilling completed: 6-16-09

If flowing, method of flow regulation: Valve _____ Other (describe) _____

Static Water Level: 41 feet above or below (circle one) land surface Date measured: 6-17-09

Method of Measurement (circle one) steel tape electric tape air line other: _____

Hole depth: 121 Well depth: 121 Well grouted to a depth of 10 feet

Type of grout (circle one): Cement Bentonite Mix

Casing length: 81 feet Casing diameter: 16 inches Type of casing: PVC

Screen length: 40 feet Screen diameter: 16 inches Type of screen: PVC

Screen slot size: .050 inches Setting depth: From 82 feet to 121 feet

Type of completion (circle all applicable): Gravel packed Underreamed Telescoped Open hole Natural Development

Other (describe): _____

Top of lap pipe or reduction in casing: _____ feet. If telescoped or more than one screen, describe on back of page

Logs run (circle all applicable) No log run Electric Gamma Ray Density Sonic Neutron Other: _____

Name of organization running log(s): _____

I certify that the well was drilled, constructed, and completed in accordance with all applicable requirements of the Mississippi Department of Environmental Quality and/or the Mississippi Department of Health regulations and state laws.

Irrigation Equipment Inc.
John P. Chism 0439

Print Name of Water Well Contractor and License No.

John
Signature of Water Well Contractor

RECEIVED
JUN 29 2009
BY: OLWR

If well telescopes please sketch below and show depths.


Ground Level

Description of Formations Encountered	From	To
Clay	0	28
Fine Sand	29	38
Fine Sand + Gravel	39	55
Medium Sand + Gravel	56	121

If more than one screen, show location of each on sketch

Sketch the property layout and include the following: 1) the well location; 2) any permanent structures on the property that may aid in locating the well; 3) any roads, power lines, or other items that may aid in locating the property and the well; 4) indicate direction.

Landowner Name: Collier Tillman

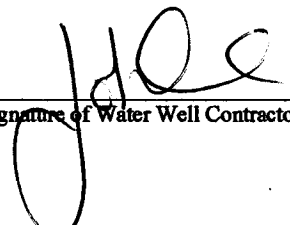

 Signature of Water Well Contractor

RECEIVED
 JUN 29 2003
 BY: OLWR

STATE WELL REPORT

Part 2

Pump Installer's Completion Report
 Mississippi Department of Environmental Quality
 Office of Land and Water Resources
 P.O. Box 10631
 Jackson, MS 39289-0631
 (601)961-5210
 (601)354-6938 (fax)

County: Leflore
 Permit #: _____
 Driller: Irrigation Equipment
 Date completed: 6-16-09

For Office Use Only:

Aquifer: _____
 Well #: A149
 Elevation: _____

This report should be prepared by the pump installer in detail and filed with the Department within 30 days of the installation of pump.


Well Owner Information	Well Location
Owner Name: <u>Collier Tillman</u>	Latitude: <u>33° 43' 33"</u> Longitude: <u>90° 21' 22"</u>
Mailing Address: <u>P.O. Box 205</u>	Method of Lat/Long (circle one): Conventional Survey, USGS quad, Hand-held GPS, Survey-grade GPS
<u>Schlater Ms. 38952</u> City State Zip Code	<u>SW 1/4 SE 1/4 Sec 36 Twn 22N Rng 2W</u>
Telephone No. <u>(662) 887-0087</u>	Distance Direction Nearest Town <u>4 Miles SW of Minter City</u>

Pump Type Circle one	Power Type Circle one
Air Lift Jet <input type="radio"/> <input checked="" type="radio"/> <u>Submersible</u>	Diesel Engine Gasoline Engine Natural Gas
Bucket Piston Turbine	<input checked="" type="radio"/> <u>Electric Motor</u> Hand Tractor PTO
Centrifugal Rotary Flowing Well	Windmill Other (specify): _____
Other (specify): _____	Horse Power Rating of Motor: <u>15</u>
Date Pump Installed: <u>6-17-09</u>	Setting Depth: <u>80</u> feet
Rated Pump Capacity: <u>750±</u> Gallons Per Minute	Number of Stages: <u>1</u>

Pump Test Data	Method of Measuring Water Level Circle one
Date Well Tested: _____	Air Line Electric Measuring Line Steel Tape
Static Water Level (A): _____ Feet Below Land Surface	Other (specify): _____
Pumping Water Level (B): _____ Feet Below Land Surface	For flowing well, measured shut in head: _____ feet
Drawdown [(B) - (A)]: _____ Feet Below Land Surface	Well yielded _____ GPM with a drawdown of _____ feet after _____ hours of pumping
Test Pumping Rate: _____ Gallons Per Minute	
Duration of Pump Test (minimum 4 hours): _____ hours	

I HEREBY CERTIFY that the above statements are true to the best of my knowledge.

John P. Chism 0439
 Print Name of Pump Installer and License No. (if applicable)

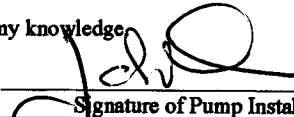
 Signature of Pump Installer

RECEIVED

JUN 29 2009

BY: OLWR

SUNFLOWER COUNTY

T 22 N


T 21 N

T 20 N

To Rufusville

To Dodsdsville

To Grenada

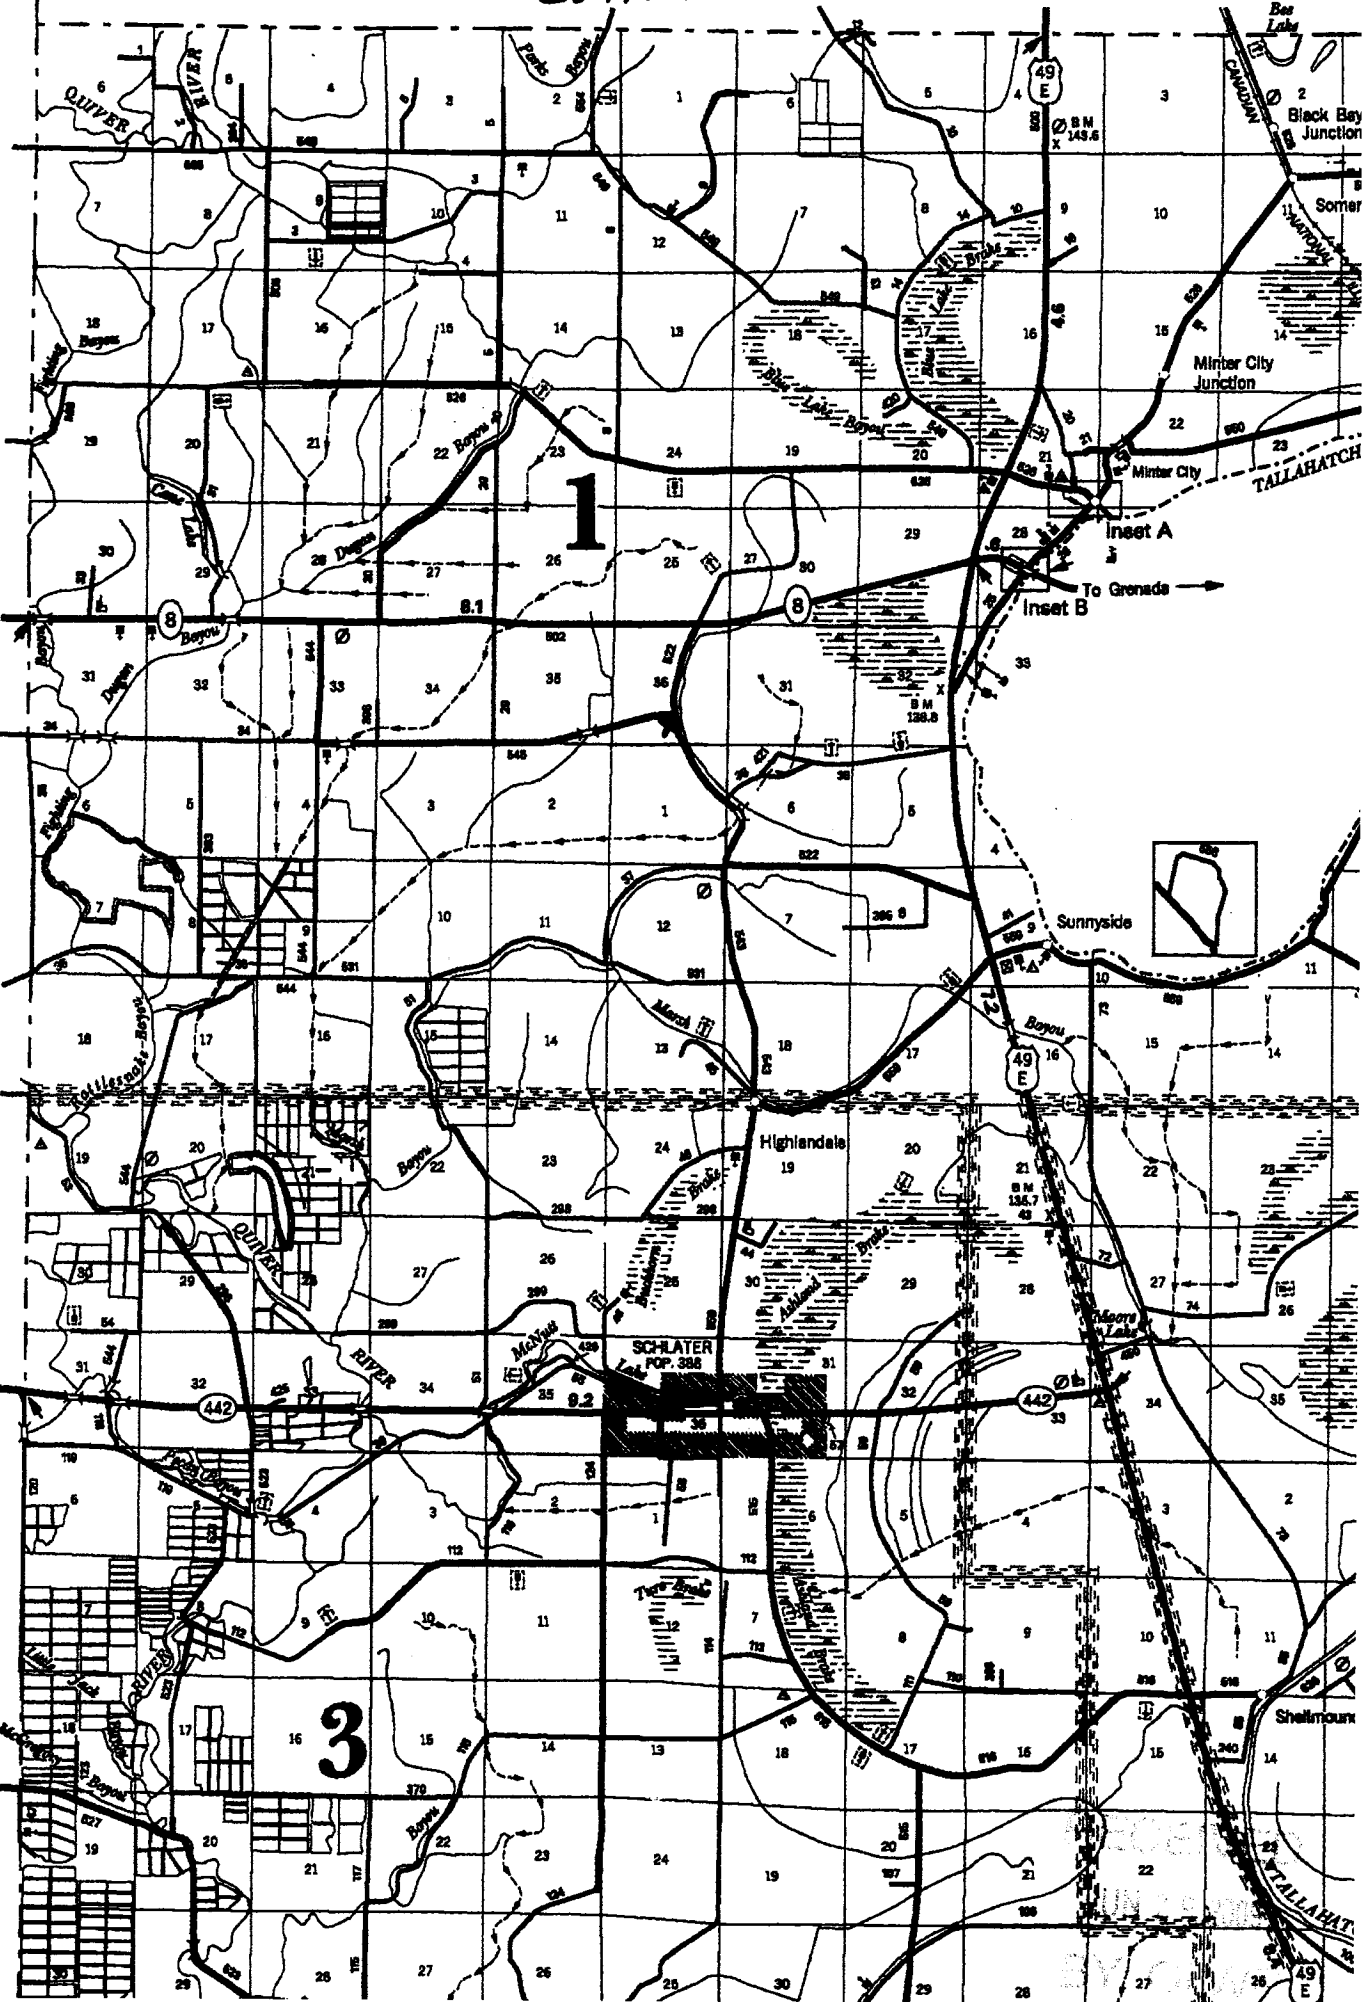

1

3

Sunnyside

Highlandale

SCHLATER

Shelmoun

TALLAHATCHE

Black Bay Junction

Somer

Minter City Junction

Minter City

Inset A

Inset B

To Suwannee

To Rufusville

To Dodsdsville

To Grenada

To Suwannee

To Suwannee

