

STATE WELL REPORT

Part 1

Driller's Log

Mississippi Department of Environmental Quality
Office of Land and Water Resources
P.O. Box 2309
Jackson, MS 39225-2309
(601)961-5210
(601)360-0535 (fax)

For Office Use Only:

Well #: A181
Aquifer: _____
E-Log #: _____

County: LEFLORE _____
Permit #: _____
Driller: MS OFFICE OF GEOLOGY
Date drilling completed: 6/30/16

State Law requires that this report be prepared by the license holder responsible for the work and filed with the Department at the above address within 30 days of completion of drilling of the well or borehole.


Well Owner Information (Landowner if borehole is not for a water well)	Well or Borehole Location
Owner Name: Delta Blues Rice	Latitude: 33 44'50" Longitude: 90 24'04"
Mailing Address: 3731 Highway 8 East	50.02 4.34 Method of Lat/Long (check one): Conventional Survey,
City: RULEVILLE State MS Zip Code 38771	USGS quad, <u>Hand-held GPS</u> , Survey-grade GPS
Telephone No. (662) 618-2060	SE/4,NE/4 Sec 28 T 22N R 2W
<u>VADOSE WELL #4</u>	<u>5</u> Miles <u>E</u> of RULEVILLE (Distance) (Direction) (Nearest Town)

Well / Borehole Data
Date drilling started: 5/10/16 Date drilling completed: 6/30/16 Hole depth: 40' Hole diameter: 7.0"
Location of the source of any surface water used for drilling: LAKE ON SITE
Method of dosing and volume of Chlorine used in drilling and development: 1 GAL BLEACH TO 1000 GALLONS WATER
Logs run (circle all applicable): <u>No log run</u> Electric Gamma Ray Density Sonic Neutron Other:
Name of organization running log(s):
Purpose of borehole (circle one): Water Well <u>Geotechnical/Geological Investigation</u> Ground Source Heat Pump Seismic Survey Other (describe)
<i>If drilling is not related to water well construction, skip the remainder of this block</i>
Purpose of Well (circle all applicable): Home Industrial Public Supply Irrigation Fish Culture
Other (describe): <u>VADOSE WELL #4</u>
If a flowing well, method of flow regulation: Valve _____ Other (describe) _____
Static Water Level: _____ feet [above or below] land surface Date measured: _____ (circle one)
Method of measurement (circle one): Steel tape Electric tape Air line Other (describe): _____
Well depth: 40 feet Well grouted to a depth of: 10 feet Type of grout (circle one): Neat Cement <u>Bentonite</u> Mix
Casing length: 30 _____ feet Casing diameter: 4 _____ inches Type of casing: PVC _____
Screen length: 10 _____ feet Screen diameter: 4 _____ inches Type of screen: PVC _____
Screen slot size: .012 _____ inches Setting depth: From 30 _____ feet to 40 _____ feet
Type of completion (circle all applicable): <u>Gravel packed</u> Underreamed Open hole Natural Development
Other (describe): _____
Top of lap pipe or reduction in casing: _____ feet
<i>If telescoped or more than one screen, describe on next page</i>

County: LEFLORE
 Permit #: _____

For Office Use Only:
 Well #: A181

The sketch below only required for water wells
If well telescopes, show depths on sketch.

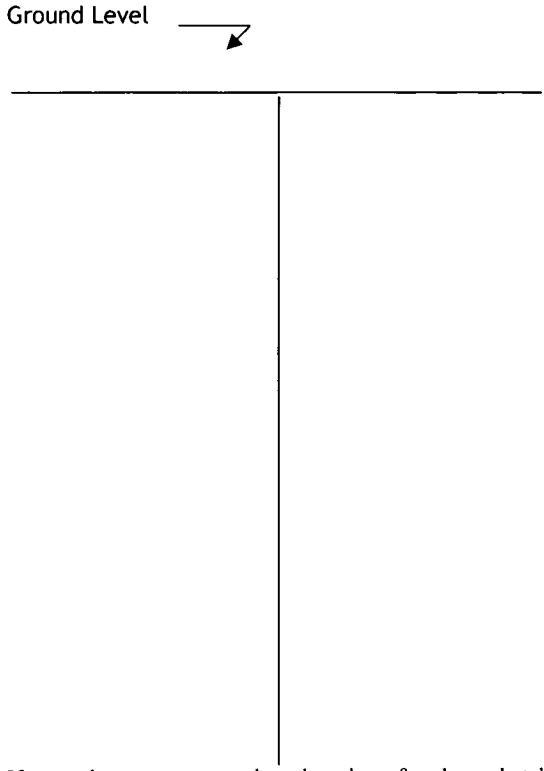

Description of formations encountered must be provided for all wells and boreholes, unless specifically exempted by regulations

Description of Formations Encountered	From (depth)	To (depth)
CLAY	Ground level	32
CRS SAND	32	40


If more than one screen, show location of each on sketch

- Sketch the property layout and include the following:
- 1) the well location
 - 2) any permanent structures on the property that may aid in locating the well
 - 3) any roads, power lines, or other items that may aid in locating the property and the well
 - 4) north arrow

Landowner Name: **Delta Blues Rice**

I HEREBY CERTIFY that the well/borehole was drilled, constructed, and completed in accordance with all applicable requirements of the Mississippi Department of Environmental Quality and the Mississippi Department of Health regulations, if applicable, and state laws.

CLETUS MAGEE 0-619
 Print Name of Responsible Licensee and License No. Date

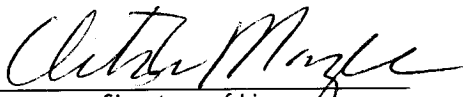
 Signature of Licensee