

Leflore
A 2000
9-30-77

MISSISSIPPI
BOARD OF WATER COMMISSIONERS
416 North State Street
Jackson, Mississippi 39201

154

WATER WELL DRILLERS LOG
BUTANE GAS COMPANY

Leflore

9-30-77
date well completed

OF GREENWOOD

county well located


LANDOWNER:	description of formations encountered	from	to
Leflore County Schools Greenwood (mailing address)	Clay Sand Sand + Gravel	0 30 60	30 60 94
WELL LOCATION: sec. <u>16</u> T. <u>22</u> N. R. <u>20</u> W. <u>7</u> miles <u>W</u> of <u>M. City</u> (distance) (direction) (nearest town)			
WELL PURPOSE: <u>Home</u> (home, irrigation, municipal, industrial)			
WELL COMPLETION DATA: (1) diameter (inches) <u>4"</u> (2) total depth (feet) <u>94</u> (3) static water level (feet) <u>28</u> <u>below</u> <u>above</u> top of ground. (4) casing <u>PVC</u> , <u>74</u> , (material) (depth) <u>4"</u> (size) if telescope see back. (5) screen <u>20</u> , <u>74</u> (length) (depth to top) <u>4"</u> , <u>PVC</u> (size) (material) (6) pump <u>1</u> , <u>20</u> (HP) (yield gpm) <u>Elec</u> (type power) (7) electric log <u>NO</u> (yes or no) (organization running log)			
DRILLERS REMARKS: <u>how well bottom plugged</u> <u>Back Pressure Valve</u>			

RECEIVED
OCT 21 1977

MISS. BD. OF WATER COMMISSIONERS

If well telescopes please sketch and show depths.

GROUND LEVEL

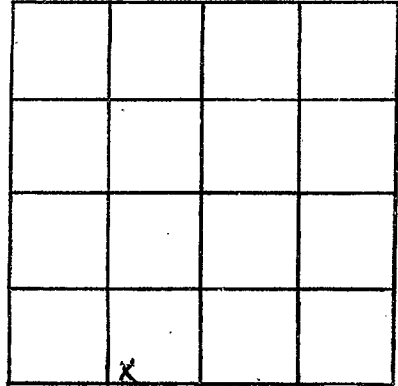

SECTION 16

Please indicate well location X.

ADDITIONAL INFORMATION

If more than one screen,
show locations of each on sketch.