

LEFLORE  
A 2007

MISSISSIPPI  
BOARD OF WATER COMMISSIONERS  
416 North State Street  
Jackson, Mississippi 39201

WATER WELL DRILLERS LOG

Sept 12, 1984 19 Lipe Well + Supply LeFlore  
date well completed firm name county well located

LANDOWNER: <u>Brooks Farm</u> <u>Drew MS</u> (mailing address)	description of formations encountered	from	to
	<u>Top soil + clay</u>	<u>0</u>	<u>20</u>
	<u>Mud. sand</u>	<u>20</u>	<u>60</u>
	<u>Red Ark</u>	<u>60</u>	<u>100</u>

WELL LOCATION:  
sec. 6 T 22 N R 2 E  
S 5 (NW)  
4 miles W of Drew  
(distance) (direction) (nearest town)

WELL PURPOSE: home  
(home, irrigation, municipal, industrial)

- WELL COMPLETION DATA:
- (1) diameter (inches) 4
  - (2) total depth (feet) 100
  - (3) static water level (feet) 40 <sup>below</sup> above top of ground.
  - (4) casing PVC, 92  
(material) (depth)  
4  
(size) if telescope see back.
  - (5) screen 8, 92  
(length) (depth to top)  
4, PVC  
(size) (material)
  - (6) pump 1/2, 10  
(HP) (yield gpm)  
elec  
(type power)
  - (7) electric log No  
(yes or no)

(organization running log)

(8) how well bottom plugged plc cap

DRILLERS REMARKS:


DEPT. OF NATURAL RESOURCES  
BUREAU OF LAND & WATER RESOURCES

JUL 10 1984

RECEIVED

If well telescopes please sketch and show depths.

GROUND LEVEL

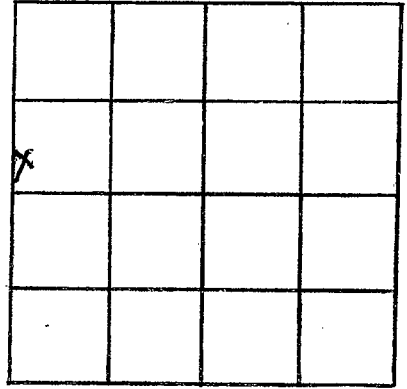

SECTION \_\_\_\_\_

Please indicate well location X.

ADDITIONAL INFORMATION

If more than one screen,  
show locations of each on sketch.