

MISSISSIPPI DEPARTMENT OF NATURAL RESOURCES

Bureau of Land and Water Resources

Southport Mall

P.O. Box 10631

Jackson, Mississippi 39209

WATER WELL DRILLERS LOG

Leflore
A-100

Apr. 6 1982 Delta Well & Supply Leflore
Date well completed firm name county well located

LANDOWNER:
Ed Scott
Drew Miss.
(mailing address)

description of formations encountered	from	to
	Top soil	0
fine sand & clay	15	45
course sand	45	60
course sand & gravel	60	105

WELL LOCATION:
sec. 3 T. 22 N. R. 2 E.
9 miles East of Drew
(distance) (direction) (nearest town)

WELL PURPOSE: Irrigation
(home, irrigation, municipal, industrial)

- WELL COMPLETION DATA:
- (1) diameter (inches) 16"
 - (2) total depth (feet) 105
 - (3) static water level (feet) 38 (below/above top of ground)
 - (4) casing Steel, 145 C.C.
(material) (depth)
(size) If telescope see back.
 - (5) screen 40'
(length) (depth to top)
16" Steel
(size) (material)
 - (6) pump 82 3000
(HP) (yield gpm)
Diesel
(type power)
 - (7) electric log no
(yes or no)
 - (8) how well bottom plugged Steel Piers

DRILLERS REMARKS:



DEPT. OF NATURAL RESOURCES
BUREAU OF LAND & WATER RESOURCES

JUN - 3 1982

RECEIVED

If well telescopes please sketch and show depths.

GROUND LEVEL

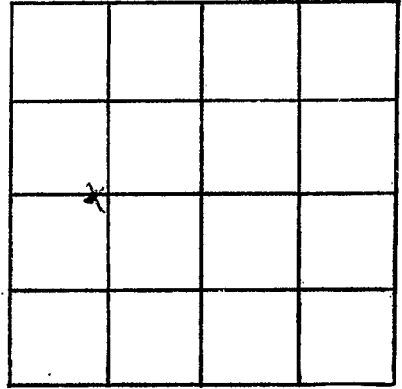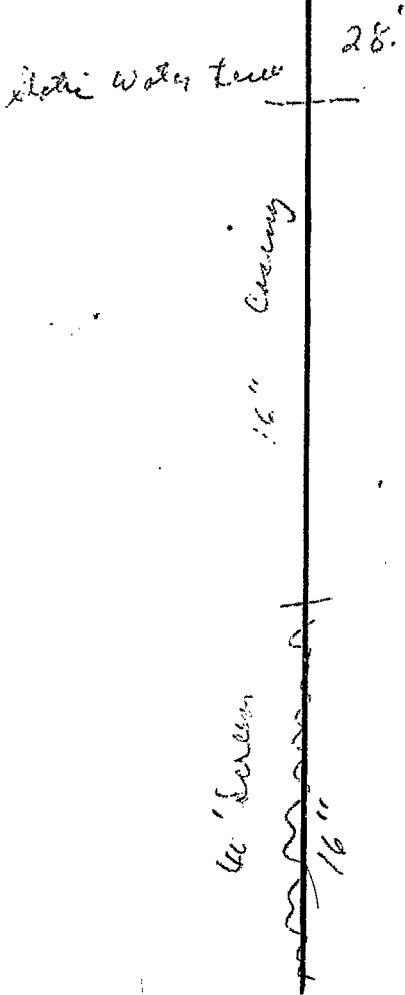

SECTION 3

Please indicate well location X.

ADDITIONAL INFORMATION

A series of horizontal lines for providing additional information.

If more than one screen, show locations of each on sketch.