

Lefflore
A-1002

MISSISSIPPI DEPARTMENT OF NATURAL RESOURCES
Bureau of Land and Water Resources
Southport Mall
P.O. Box 10631
Jackson, Mississippi 39209
WATER WELL DRILLERS LOG

Jan. 4 1982 Dyer Well + Irrigation Lefflore
date well completed firm name county well located

LANDOWNER: Guy Britt

Minter City
(mailing address)

WELL LOCATION:
sec. 14 T. 22 N. R. 2 E. S. 6
W miles 6 of Minter City
(distance) (direction) (nearest town)

WELL PURPOSE: Irrigation
(home, irrigation, municipal, industrial)

WELL COMPLETION DATA:

- (1) diameter (inches) 12 3/4"
- (2) total depth (feet) 103
- (3) static water level (feet) 14 ^{below} ~~above~~ top of ground.
- (4) casing Steel, 143' C.C.
(material) (depth)
12 3/4" if telescope see back.
(size)
- (5) screen 40'
(length) (depth to top)
12 3/4", Mild Steel
(size) (material)
- (6) pump 40 2500
(HP) (yield gpm)
diesel
(type power)
- (7) electric log No
(yes or no)
- (organization running log)
- (8) how well bottom plugged Plate


description of formations encountered	from	to
Clay	0	13
Clay	13	23
Fine sand + Clay	23	33
Fine sand + Clay	33	43
Course Sand	43	53
Course sand	53	63
sand + Gravel	63	73
sand + Gravel	73	83
Sand + Gravel	83	93
Sand + Gravel	93	103

DRILLERS REMARKS:

DEPT. OF NATURAL RESOURCES
BUREAU OF LAND & WATER RESOURCES
MAY - 4 1982
RECEIVED

If well telescopes please sketch and show depths.

GROUND LEVEL

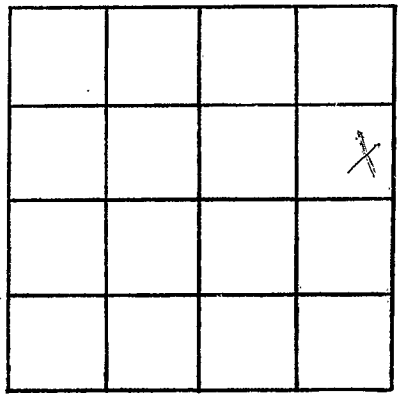

SECTION 14

Please indicate well location X.

ADDITIONAL INFORMATION

A series of horizontal lines for writing additional information.

If more than one screen, show locations of each on sketch.