

LEFLORE
A 2003
9-16-77

MISSISSIPPI
 BOARD OF WATER COMMISSIONERS
 416 North State Street
 15H Jackson, Mississippi 39201

WATER WELL DRILLERS LOG
BUTANE GAS COMPANY

9-16-77 19 **OF GREENWOOD** Leflore
 date well completed firm name county well located

LANDOWNER:
 R. L. Kyle
 Minter City
 (mailing address)

description of formations encountered	from	to
Clay	0	30
SAND	30	50
SAND + GRAVEL	50	153

WELL LOCATION:
 sec. 36 T 22 N R 2 E 1 W
 3 1/2 miles SW of Minter City
 (distance) (direction) (nearest town)

Clay	153	190
Siltstone	190	275
SANDY Siltstone	275	343
SAND	343	440
Siltstone	440	490

WELL PURPOSE: Home
 (home, irrigation, municipal, industrial)

Siltstone + Rock	490	520
SAND	520	553

WELL COMPLETION DATA:

(1) diameter (inches) 4 x 2

(2) total depth (feet) 934 well

(3) static water level (feet) 0 below top of ground

(4) casing steel 914 (depth)
 4 x 2 (size) if telescope see back.

(5) screen 20' 914 (length) (depth to top)
 2" stainless (size) (material)

(6) pump 1 (HP) 20 (yield gpm)
 Elec (type power)

(7) electric log NO (yes or no)
 (organization running log)

(8) how well bottom plugged Lead Plug

SANDY siltstone	553	745
Gummy Siltstone	745	780
Siltstone + Rock	780	838
FINE SAND	838	870
Fine sand + siltstone	870	905
SAND	905	938
SAND + Siltstone	938	983
		How

RECEIVED

SEP 27 1977

MISS. DD. OF WATER COMMISSIONERS

DRILLERS REMARKS:


If well telescopes please sketch and show depths.

GROUND LEVEL

105' - 4" CASING →

809' - 2" CASING →

20' - 3" SCREEN →

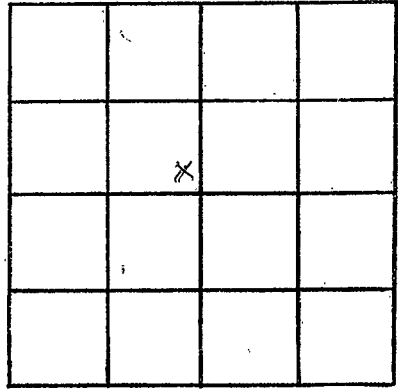

SECTION 36

Please indicate well location X.

ADDITIONAL INFORMATION

If more than one screen, show locations of each on sketch.