

Leflore
A-1003

MISSISSIPPI DEPARTMENT OF NATURAL RESOURCES
Bureau of Land and Water Resources
Southport Mall
P.O. Box 10631
Jackson, Mississippi 39209
WATER WELL DRILLERS LOG

Dec. 21 1981 Pyer Well + Irrigation Leflore
date well completed firm name county well located

LANDOWNER: Guy Britt

Minter City
(mailing address)

WELL LOCATION:
sec. 10 T 22 (N) R 2 E
S (W)
N.W. miles 7 of Minter City
(distance) (direction) (nearest town)

WELL PURPOSE: Irrigation
(home, irrigation, municipal, industrial)

WELL COMPLETION DATA:

- (1) diameter (inches) 10
- (2) total depth (feet) 103 wells
- (3) static water level (feet) 15 below above
top of ground.
- (4) casing 1 1/2" Steel, 143, cl
(material) (depth)
- 10"
(size) if telescope see back.
- (5) screen 40',
(length) (depth to top)
10", Mild Steel
(size) (material)
- (6) pump 30, 1800
(HP) (yield gpm)
Diesel
(type power)
- (7) electric log No
(yes or no)

(organization running log)
- (8) how well bottom plugged Plate

description of formations encountered	from	to
<u>CLAY</u>	<u>0</u>	<u>13</u>
<u>CLAY</u>	<u>13</u>	<u>23</u>
<u>CLAY</u>	<u>23</u>	<u>33</u>
<u>SAND</u>	<u>33</u>	<u>43</u>
<u>SAND</u>	<u>43</u>	<u>53</u>
<u>SAND + GRAVEL</u>	<u>53</u>	<u>63</u>
<u>SAND + GRAVEL</u>	<u>63</u>	<u>73</u>
<u>SAND + GRAVEL</u>	<u>73</u>	<u>83</u>
<u>SAND + GRAVEL</u>	<u>83</u>	<u>93</u>
<u>SAND + GRAVEL</u>	<u>93</u>	<u>103</u>

DRILLERS REMARKS:


DEPT. OF NATURAL RESOURCES
BUREAU OF LAND & WATER RESOURCES

MAY - 4 1982

RECEIVED

If well telescopes please sketch and show depths.

GROUND LEVEL

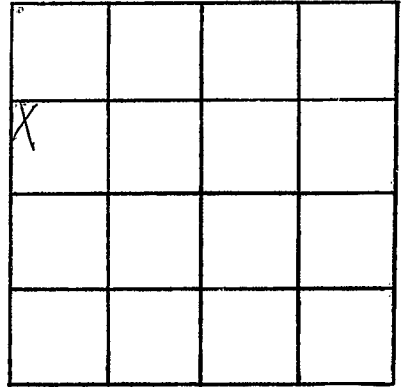

SECTION 10

Please indicate well location X.

ADDITIONAL INFORMATION

If more than one screen,
show locations of each on sketch.