

LeFlora  
A 9004  
9-6-77

MISSISSIPPI  
 BOARD OF WATER COMMISSIONERS  
 416 North State Street  
 154 Jackson, Mississippi 39201

WATER WELL DRILLERS LOG

9-6-77 19 BUTANE GAS CO. OF GREENWOOD LeFlora  
 date well completed firm name county well located

LANDOWNER:  
HORACE E. BRITTON, JR.  
Winter City  
 (mailing address)

WELL LOCATION:  
 sec. 12 T. 27 N. R. 2 E  
4 miles NE of Winter City  
 (distance) (direction) (nearest town)

WELL PURPOSE: Home  
 (home, irrigation, municipal, industrial)

WELL COMPLETION DATA:

(1) diameter (inches) 4 1/2

(2) total depth (feet) 980 well

(3) static water level (feet) 6 below top of ground.

(4) casing Steel 960 cc  
 (material) (depth)  
4 1/2 If telescope see back.  
 (size)

(5) screen 20 960  
 (length) (depth to top)  
2" Stainless  
 (size) (material)

(6) pump 1 20  
 (HP) (yield gpm)

Electric  
 (type power)

(7) electric log No.  
 (yes or no)

(organization running log)

(8) how well bottom plugged Lead Plug

description of formations encountered	from	to
Clay	0	25
Sand	25	55
Gravel	55	133
Sand	133	170
Sand + Shale	170	260
Rock	260	263
Shale + Rock	263	380
Sand	380	385
Sandy Shale	385	423
Gummy Shale	423	458
Shale + Rock	458	660
Shale	660	720
Sand	720	742
Sandy Shale	742	785
Sand	785	810
Shale	810	835
Sand	835	850
Gummy Shale	850	900
Sand + Shale	900	930
Sandy Shale	930	955
Sand	955	980
Shale	980	986
		Well

**RECEIVED**  
 SEP 15 1977

MISS. RD.


If well telescopes please sketch and show depths.

GROUND LEVEL

705' - 4" CASING →

855' - 2" CASING →

920' - 2" SCREEN →

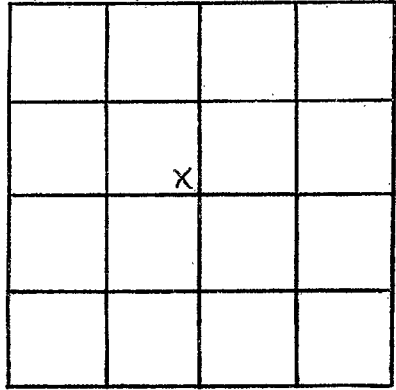

SECTION 12

Please indicate well location X.

ADDITIONAL INFORMATION

If more than one screen,  
show locations of each on sketch.