

Leflore MISSISSIPPI BOARD OF WATER COMMISSIONERS

B9
11-26-60

MS-GW-4154
WATER WELL DRILLERS LOG

B-300
B9

Date: Nov. 26, 19 60, Driller: Layne-Central Company County Leflore

(Name)

ceded
(1) Owner of Land: Minter City Oil Mill

(Name)

Minter City, Mississippi

(Address)

(2) Location: 1/4, 1/4, Sec. 21 T22R1W

0 miles
(distance)

(direction)

Minter City
(Nearest Town)

(3) Topography: level

(Hilly)

(Flat)

(Level)

(4) Purpose of Well: industrial

(Domestic Irrigation
Municipal, Industrial, Other)

Information upon completion of well:

(1) Diameter 10x6 inches.

(2) Total Depth 325 feet.

(3) Water Level 21'-6" feet below top of ground.

(4) Cased to 184'
113', Size 10"
6"

(5) Screen: Size 6", Length 50'-6"

(6) Were any formations sealed against pollution?

X yes, no.


If YES depth of formation mechanical lead
seal

Why to eliminate all other
formations.

Drillers Remarks:

Description & Color of Materials Sand, Clay, Red Clay, Shell, etc.	Thick- ness Feet	Depth Feet
Clay	15	15
Fine sand	15	30
Coarse sand	49	79
Coarse sand & gravel	28	107
Rock	3	110
Coarse sand & big gravel	60	170
Clay	6	176
Sandy shale	29	205
Medium fine sand	120	325

ceded

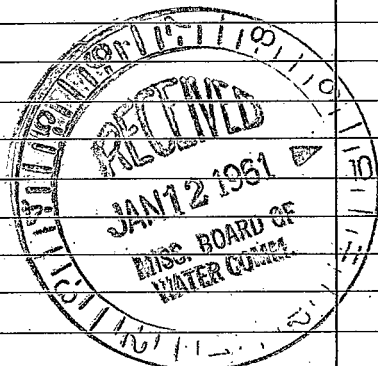

Well No.

(Use Back Side)

