

# LEFLORE MISSISSIPPI BOARD OF WATER COMMISSIONERS

B 19

## WATER WELL DRILLERS LOG

7-19-65

Date: July 19, 1965, Driller: DELTA DRILLING Co. County LEFLORE  
 E Log # 59 (Name)

(1) Owner of Land: FRANK LEAVEL  
 (Name)

WINTER CITY, MISS  
 (Address)

(2) Location: NW 1/4, NW 1/4, Sec. 33 T22R1

\_\_\_\_\_ miles \_\_\_\_\_ of \_\_\_\_\_  
 (distance) (direction) (Nearest Town)

(3) Topography: \_\_\_\_\_  
 (Hilly) (Flat) (Level)

(4) Purpose of Well: DOMESTIC  
 (Domestic Irrigation  
 Municipal, Industrial, Other)

Description & Color of Materials Sand, Clay, Red Clay, Shell, etc.	Thick- ness Feet	Depth Feet
Gumbo	44	44
SAND	30	74
GRAVEL	44	118
SAND w/18" ROCK	39	157
Gumbo	113	270
Shale	47	317
Sand	61	378
Shale	20	398
Sand	69	467
Gumbo w/18" ROCK	86	553
Shale	22	575
Gumbo w/14" ROCK	27	602
GREEN Sand	18	620
Shale	32	652
Green sand	30	682
Gumbo	22	704
GREEN Sand	26	730
Shale	26	756
Gumbo	39	795
Sand	39	834
Shale	18	852
Sand	8	860
Shale	26	886
Gumbo	8	894
Sand	38	932
Shale	8	940
Sand	50	990
Shale	12	1002
Sand	66	1068

Information upon completion of well:

(1) Diameter 3 inches.

(2) Total Depth 1068 feet.

(3) Water Level FLOWS feet below top of ground. 580'-3"

(4) Cased to 1048, Size 493'-2"

(5) Screen: Size 2", Length 20'


(6) Were any formations sealed against pollution?  
 \_\_\_\_\_ yes, \_\_\_\_\_ no.

If YES depth of formation \_\_\_\_\_

Why \_\_\_\_\_

Drillers Remarks: 2.5' lap of 2"

In 3" pipe -

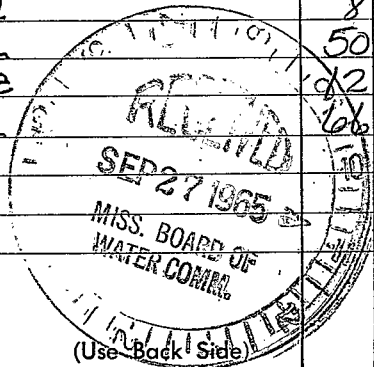

Well No.

