


MISSISSIPPI BOARD OF WATER COMMISSIONERS

B 19 20
9-16-65

WATER WELL DRILLERS LOG CODED

Date: SEPT 16, 1965, Driller: DELTA DRILLING Co. County LEFLORE
(Name)

	Description & Color of Materials <small>Sand, Clay, Red Clay, Shell, etc.</small>	Thick- ness Feet	Depth Feet
(1) Owner of Land: <u>FRANK LEAVELL</u> <small>(Name)</small>	<u>Gumbo</u>	<u>20</u>	<u>20</u>
<u>MINTER CITY, MISS</u> <small>(Address)</small>	<u>Sand</u>	<u>44</u>	<u>64</u>
(2) Location: <u>NE 1/4, NW 1/4, Sec. 33</u> <u>R2N1W</u>	<u>GRAVEL</u>	<u>86</u>	<u>150</u>
<u> </u> miles <u> </u> of <u> </u> <small>(distance) (direction) (Nearest Town)</small>	<u>Gumbo</u>	<u>153</u>	<u>303</u>
(3) Topography: <u> </u> <small>(Hilly) (Flat) (Level)</small>	<u>Sand</u>	<u>32</u>	<u>335</u>
(4) Purpose of Well: <u>DOMESTIC</u> <small>(Domestic Irrigation, Municipal, Industrial, Other)</small>	<u>Gumbo w/ Rocks</u>	<u>44</u>	<u>379</u>
Information upon completion of well: (1) Diameter <u>4</u> inches. (2) Total Depth <u>886</u> feet. (3) Water Level <u>FLOWS</u> feet below top of ground. (4) Cased to <u>768</u> , Size <u>1 7/8" x 2 1/2"</u> (5) Screen: Size <u>2 1/2"</u> , Length <u>20'</u> (6) Were any formations sealed against pollution? <u> </u> yes, <u> </u> no. If YES depth of formation <u> </u> Why <u> </u> Drillers Remarks: <u>20' GAP OF 2 1/2"</u> <u>IN 4" PIPE.</u>	<u>Green Sand CODED</u>	<u>65</u>	<u>444</u>
	<u>Shale w/ Rocks</u>	<u>80</u>	<u>524</u>
	<u>Gumbo</u>	<u>20</u>	<u>544</u>
	<u>Shale</u>	<u>37</u>	<u>581</u>
	<u>gumbo</u>	<u>19</u>	<u>600</u>
	<u>Shale</u>	<u>46</u>	<u>646</u>
	<u>Sand</u>	<u>30</u>	<u>676</u>
	<u>Shale</u>	<u>49</u>	<u>725</u>
	<u>Gumbo</u>	<u>12</u>	<u>737</u>
	<u>Sand</u>	<u>46</u>	<u>783</u>
	<u>Shale</u>	<u>22</u>	<u>805</u>
	<u>SAND</u>	<u>30</u>	<u>835</u>
<u>Clay</u>	<u>51</u>	<u>886</u>	

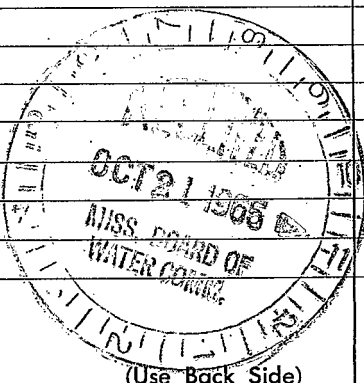

Well No.

