

CODED

CODED

CODED

*Leflore*  
 B 22  
 10-5-68

MISSISSIPPI  
 BOARD OF WATER COMMISSIONERS  
 416 North State Street  
 Jackson, Mississippi 39201

WATER WELL DRILLERS LOG

10/5/68 date well completed      19 *Buttave Gas Co. of G'wood* firm name      *Leflore* county well located

LANDOWNER:

*EQUEN PLANTING Co.*  
*Minster City, Miss*  
 (mailing address)

description of formations encountered

from to

<i>Clay</i>	0	35
<i>Sand</i>	35	55
<i>SAND + GRAVEL</i>	55	84

WELL LOCATION:

sec *6* T *22* N R *1* E  
W  
*4* miles *NW* of *Minster City*  
 (distance) (direction) (nearest town)

WELL PURPOSE:

(home, irrigation, municipal, industrial)


WELL COMPLETION DATA:

- (1) diameter (inches) 4
- (2) total depth (feet) 84
- (3) static water level (feet) 18 below top of ground.
- (4) casing Steel, 74,  
(material) (depth)  
4 X 2 if telescope see back.  
(size)
- (5) screen 10, 74  
(length) (depth to top)  
2", Stainless Steel  
(size) (material)
- (6) pump 1 20  
(HP) (yield gpm)  
Elec.  
(type power)
- (7) electric log NO  
(yes or no)

(organization running log)

- (8) how well bottom plugged BACK PRESSURE VALVE

DRILLERS REMARKS:

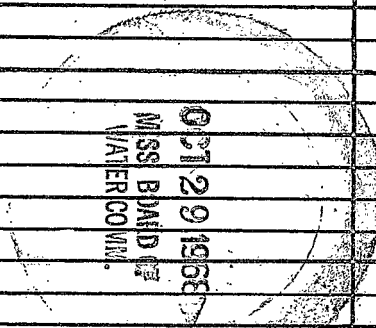

If well telescopes please sketch and show depths.

GROUND LEVEL

74 ft.  
4" Galv.  
CASINGS

10 ft.  
2" STAINLESS  
Steel SCREEN

			X

SECTION 6

Please indicate well location X.

ADDITIONAL INFORMATION

If more than one screen,  
show locations of each on sketch.