

**MISSISSIPPI
BOARD OF WATER COMMISSIONERS**
416 North State Street
Jackson, Mississippi 39201
MS-BW-3401
WATER WELL DRILLERS LOG

Leflore
B 24
10-10-69

10/10 19 *69 Butane GAS Co. of Good* *Leflore*
date well completed firm name county well located

LANDOWNER:
Leflore County School
Winter City, Miss.
(mailing address)

WELL LOCATION:
sec. *21* T *22* N R *1 E*
S W
1 miles *W* of *Winter City*
(distance) (direction) (nearest town)

WELL PURPOSE: *School*
(home, irrigation, municipal, industrial)

WELL COMPLETION DATA:

(1) diameter (inches) *8"*

(2) total depth (feet) *1051*

(3) static water level (feet) *6* below above top of ground.

(4) casing *Steel*, *1031*,
(material) (depth)

8 x 4 if telescope see back.
(size)

(5) screen *20'*, *1031*
(length) (depth to top)
4", *Stainless Steel*
(size) (material)

(6) pump *7 1/2*, *75*
(HP) (yield gpm)
Elec.
(type power)

(7) electric log *NO*
(yes or no)

(organization running log)

(8) how well bottom plugged
Back Pressure Valve

description of formations encountered	from to	
<i>Clay</i>	<i>0</i>	<i>13</i>
<i>SAND</i>	<i>13</i>	<i>73</i>
<i>SAND + GRAVEL</i>	<i>73</i>	<i>118</i>
<i>Rock</i>	<i>118</i>	<i>119</i>
<i>SHALE</i>	<i>119</i>	<i>135</i>
<i>Rock</i>	<i>135</i>	<i>136</i>
<i>SHALE</i>	<i>136</i>	<i>137</i>
<i>Rock</i>	<i>137</i>	<i>138</i>
<i>HARD SHALE</i>	<i>138</i>	<i>315</i>
<i>SAND</i>	<i>315</i>	<i>350</i>
<i>SHALE</i>	<i>350</i>	<i>271</i>
<i>Rock</i>	<i>371</i>	<i>372</i>
<i>SHALE</i>	<i>372</i>	<i>373</i>
<i>Rock</i>	<i>373</i>	<i>375</i>
<i>SAND + SHALE</i>	<i>375</i>	<i>642</i>
<i>HARD SHALE</i>	<i>642</i>	<i>806</i>
<i>Gummy SHALE</i>	<i>806</i>	<i>864</i>
<i>SAND</i>	<i>864</i>	<i>891</i>
<i>Rock</i>	<i>891</i>	<i>892</i>
<i>Gummy SHALE</i>	<i>892</i>	<i>910</i>
<i>HARD SHALE</i>	<i>910</i>	<i>955</i>
<i>Rock</i>	<i>955</i>	<i>956</i>
<i>SANDY SHALE</i>	<i>956</i>	<i>983</i>
<i>HARD PACKED SAND</i>	<i>983</i>	<i>1060</i>
<i>SHALE</i>	<i>1060</i>	<i>1072</i>

007 20 1969

DRILLERS REMARKS:


If well telescopes please sketch and show depths.

GROUND LEVEL

149'-8" CASING →

882'-4" CASING →

20'-4" STAINLESS
STEEL SCREEN

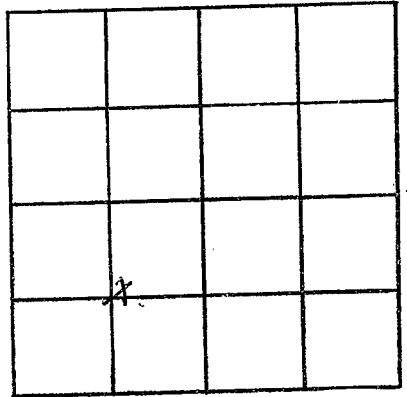

SECTION 21

Please indicate well location X.

ADDITIONAL INFORMATION

If more than one screen,
show locations of each on sketch.