

B-28

12-10-63

WATER WELL DRILLERS LOG

CODED

Date: DEC 10, 1963, Driller: DELTA DRILLING Co. County LEFLORE

(Name)

(1) Owner of Land: H.C. PLEASANTS

(Name)

WINTER CITY, MISS

(Address)

(2) Location: 1/4, 1/4, Sec. 20 T22R1W

 miles of
(distance) (direction) (Nearest Town)

(3) Topography:

(Hilly) (Flat) (Level)

(4) Purpose of Well: DOMESTIC

(Domestic Irrigation
Municipal, Industrial, Other)

Information upon completion of well:

(1) Diameter 3 inches.

(2) Total Depth 981 feet.

(3) Water Level FLOWS feet below top of ground.

3" 593'

(4) Cased to 961, Size 2" - 388

(5) Screen: Size 2", Length 20'

(6) Were any formations sealed against pollution?

 yes, no.


If YES depth of formation

Why

Drillers Remarks:

Description & Color of Materials Sand, Clay, Red Clay, Shell, etc.	Thick- ness Feet	Depth Feet
GUMBO	22	22
SAND	63	85
GRAVEL	64	149
SAND	30	179
GUMBO	22	201
SAND	41	242
GUMBO	73	315
SHALE	16	331
GREEN SAND	20	351
GUMBO	71	422
GREEN SAND	52	474
SHALE	81	555
GREEN SAND	62	617
SHALE	28	645
GREEN SAND	50	695
GUMBO	20	715
SHALE	68	773
SAND	36	809
SHALE	40	849
GUMBO	18	867
SAND	10	877
GUMBO	16	893
SAND	18	911
SHALE	19	930
SAND	51	981

CODED

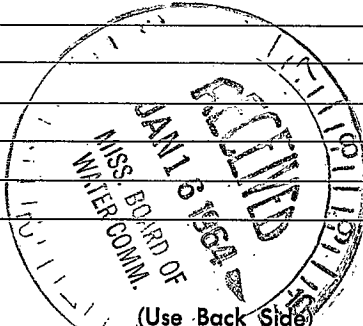

Well No.

804

804

1