

LeFLORE
B31
6-1-72

MISSISSIPPI
BOARD OF WATER COMMISSIONERS
416 North State Street
Jackson, Mississippi 39201

CODED

WATER WELL DRILLERS LOG
BUTANE GAS CO. OF GREENWOOD *Leflore*

6-1-72 19
date well completed

firm name

county well located

LANDOWNER:

Bishop Cotton Ladd
Minster City
(mailing address)

description of formations encountered

from

to

<i>Clay</i>	<i>0</i>	<i>13</i>
<i>Broken sand</i>	<i>13</i>	<i>33</i>
<i>Sand + Gravel</i>	<i>33</i>	<i>50</i>
<i>Fine sand</i>	<i>50</i>	<i>72</i>
<i>Sand + Gravel</i>	<i>72</i>	<i>93</i>

WELL LOCATION:

sec. *14* T. *2* N. R. *1* E. W. *2*
(distance) miles *NE* of *M. City*
(direction) (nearest town)

WELL PURPOSE:

IRR
(home, irrigation, municipal, industrial)

WELL COMPLETION DATA:

- (1) diameter (inches) *12*"
- (2) total depth (feet) *73*
- (3) static water level (feet) *18* *below* top of ground. *above*
- (4) casing *Steel*, *73*
(material) (depth)
12" if telescope see back.
(size)
- (5) screen *20'*, *73*
(length) (depth to top)
12" *Steel*
(size) (material)
- (6) pump *40* *1500*
(HP) (yield gpm)
Diesel Tractor
(type power)
- (7) electric log *NO*
(yes or no)

CODED

JUN - 6 1972

MISS. BD. OF
WATER COMMISSIONERS


DRILLERS REMARKS:

(8) how well bottom plugged *Steel Plate*

(organization running log)

If well telescopes please sketch and show depths.

GROUND LEVEL

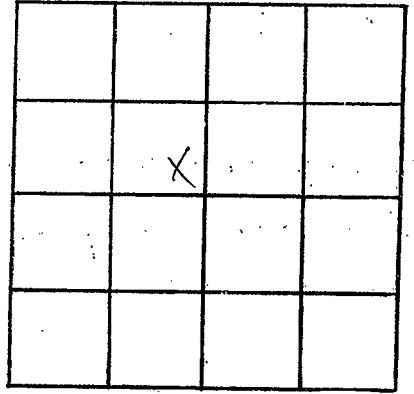

SECTION 14

Please indicate well location X.

ADDITIONAL INFORMATION

If more than one screen,
show locations of each on sketch.