

LeFLORE  
B 32  
6-22-72

MISSISSIPPI  
 BOARD OF WATER COMMISSIONERS  
 416 North State Street  
 Jackson, Mississippi 39201

**CODED**

WATER WELL DRILLERS LOG 1724-3856

June 22, 1972 Singer-Layne Central Division Leflore  
 date well completed firm name county well located

LANDOWNER: Equen & McBee Planting Company	Description of formations encountered	from	to
Minter City, Mississippi (mailing address)	Clay	0	16
	Sand	16	41
	Coarse sand, pea gravel	41	65
	Gravel, coarse sand	65	109
	Boulders	109	112
<b>WELL LOCATION:</b>			
sec. <u>8</u> T. <u>22</u> R. <u>1</u> 4 miles NW of Minter City (distance) (direction) (nearest town)			
<b>WELL PURPOSE:</b> irrigation (home, irrigation, municipal, industrial)			
<b>WELL COMPLETION DATA:</b>			
(1) diameter (inches) <u>12</u>			
(2) total depth (feet) <u>112</u>			
(3) static water level (feet) <u>16' 2" below</u> top of ground. <del>above</del>			
(4) casing <u>steel</u> , <u>72'</u> (material) (depth) <u>12"</u> if telescope see back. (size)			
(5) screen <u>40'</u> , <u>112'</u> (length) (depth to top) <u>12"</u> , <u>steel</u> (size) (material)			
(6) pump <u>60</u> <u>2000</u> (HP) (yield gpm) <u>engine</u> (type power)			
(7) electric log <u>no</u> (yes or no)			
(8) how well bottom plugged <u>plate</u>			
<b>DRILLERS REMARKS:</b>			


**CODED**

JUL 24 1972

MISS. BD. OF  
 WATER COM.

If well telescopes please sketch and show depths.

GROUND LEVEL

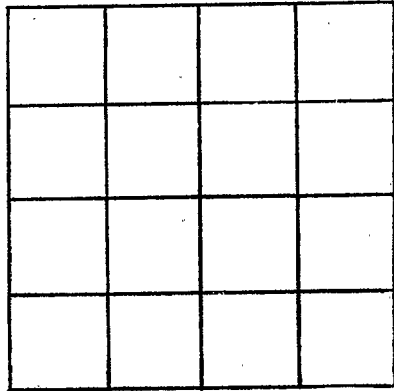

SECTION \_\_\_\_\_

Please indicate well location X.

ADDITIONAL INFORMATION

If more than one screen, show locations of each on sketch.