

LEFLORE
B 33
8-22-72

MISSISSIPPI
 BOARD OF WATER COMMISSIONERS
 416 North State Street
 Jackson, Mississippi 39201

WATER WELL DRILLERS LOG

CODED

8-22-72 1972 BUTANE GAS CO. OF GREENWOOD Leflore
 date well completed firm name county well located

LANDOWNER:
Edwen & Mc Bee
Minter City
 (mailing address)

description of formations encountered	from	to
CLAY	0	10
SAND & GRAVEL	10	135
SHALE & CLAY	135	210
CLAY	210	380
SHALE & CLAY	380	400
SHALE	400	600
SAND & SHALE	600	715
SAND	715	774

WELL LOCATION:
 sec. 5 T 22 N R. 10 W
3 1/2 miles NW of Minter City
 (distance) (direction) (nearest town)

WELL PURPOSE: Home
 (home, irrigation, municipal, industrial)

WELL COMPLETION DATA:
 (1) diameter (inches) 4 1/2
 (2) total depth (feet) 755
 (3) static water level (feet) 10 ^{below} above top of ground.
 (4) casing Steel, 735,
 (material) (depth)
4 1/2 if telescope see back.
 (size)
 (5) screen 20', 735'
 (length) (depth to top)
2", STAINLESS
 (size) (material)
 (6) pump 1, 25
 (HP) (yield gpm)
Elec.
 (type power)
 (7) electric log No
 (yes or no)

CODED

(organization running log)

SEP 19 1972

(8) how well bottom plugged:
Lead Plug

DRILLERS REMARKS:

MISS. DEP. OF
 WATER CONTROL


If well telescopes please sketch and show depths.

GROUND LEVEL

105' - 4" CASING

630' - 2" CASING

20' - 2" SCREEN

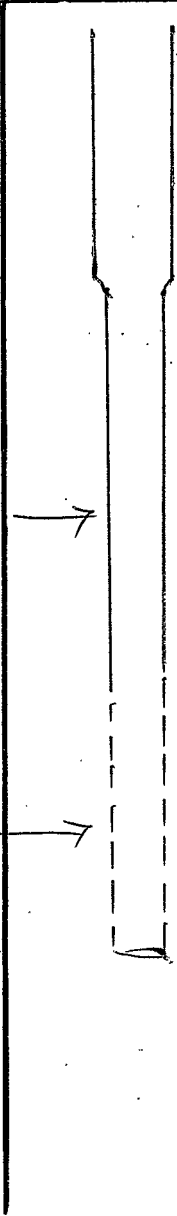

		X	

SECTION 5

Please indicate well location X.

ADDITIONAL INFORMATION

If more than one screen, show locations of each on sketch.