

Leflore
B 34
11-8-72

MISSISSIPPI
 BOARD OF WATER COMMISSIONERS
 416 North State Street
 Jackson, Mississippi 39201

WATER WELL DRILLERS LOG

11-8-72 19 BUTANE GAS CO. OF GREENWOOD Leflore
 date well completed firm name county well located

LANDOWNER:
B. J. Roberson
Winter City
 (mailing address)

description of formations encountered	from	to
CLAY	0	13
FINE SAND	13	33
COARSE SAND	33	63
SAND & GRAVEL	63	93
ROCK	93	

WELL LOCATION:
 sec. 5 T 22 N R. 1 E
 & 5 miles NE of Winter City
 (distance) (direction) (nearest town)

WELL PURPOSE: IRR.
 (home, irrigation, municipal, industrial)

WELL COMPLETION DATA:

(1) diameter (inches) 16

(2) total depth (feet) 93

(3) static water level (feet) 18 below above top of ground.

(4) casing Steel 53
 (material) (depth)
12 if telescope see back.
 (size)

(5) screen 40 53
 (length) (depth to top)
16 Steel
 (size) (material)

(6) pump 50 2,000
 (HP) (yield gpm)
Elec.
 (type power)

(7) electric log ND
 (yes or no)
 (organization running log)

(8) how well bottom plugged
Steel Plate


NOV 17 1972

MISS. DEP. OF
 LAND AND
 WATER RESOURCES

DRILLERS REMARKS:

If well telescopes please sketch and show depths.

GROUND LEVEL

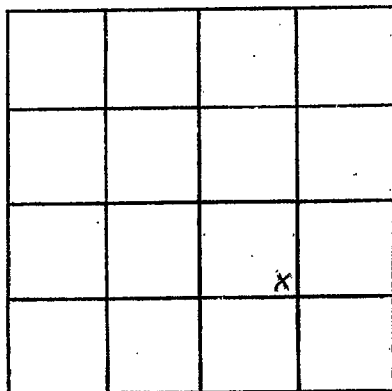

SECTION 5

Please indicate well location X.

ADDITIONAL INFORMATION

If more than one screen,
show locations of each on sketch.