

MISSISSIPPI
BOARD OF WATER COMMISSIONERS
416 North State Street
Jackson, Mississippi 39201

CODED

LEFLORE
B 35
11-20-72

WATER WELL DRILLERS LOG

11-20 19 72 DYER WELL & IRRIGATION SERVICE LEFLORE
date well completed firm name county well located

LANDOWNER: ANNIE DEGRIP
MINTON CITY

(mailing address)

WELL LOCATION:
sec. 22 T 22 N R. LX
3 1/2 miles N.E. of MINTON CITY
(distance) (direction) (nearest town)

WELL PURPOSE: Homes
(home, irrigation, municipal, industrial)

WELL COMPLETION DATA:

- (1) diameter (inches) 4" x 3"
- (2) total depth (feet) 702'
- (3) static water level (feet) 220' below top of ground.
- (4) casing BERTA 672' (material), (depth) 168' 4" 504' 3" (size) if telescope see back.
- (5) screen 30' 672' (length), (depth to top) 3" STAINLESS STEEL (size), (material)
- (6) pump 3 (HP) 70 (yield gpm)
- (7) electric log NO (yes or no)
- (organization running log)
- (8) how well bottom plugged B.P.D.

description of formations encountered	from	to
Clay	0	18
Fine sand	18	48
Sand	40	72
Sand & gravel	72	90
Clay	90	110
Shale Sand st.	110	130
Shale	130	237
Rock	237	244
Shale	244	247
Rock	247	249
Shale Rock st.	249	260
Shale	260	275
Rock	275	276
Shale	276	285
Rock	285	286
Shale Rock st.	286	302
Sand	302	312
Shale	312	317
Rock	317	318
Shale	318	331
Rock	331	334
Shale & Rock st.	334	359
Sandy shale	359	422
Shale & Rock st	422	471
Shale	471	513
Sand & Shale st	513	585
Sandy shale	585	620
Sand	620	702


JUN 27 1973

DRILLERS REMARKS:

If well telescopes please sketch and show depths.

GROUND LEVEL

4" DIRECT COMPLET
WITH SWAGE NIPPLE

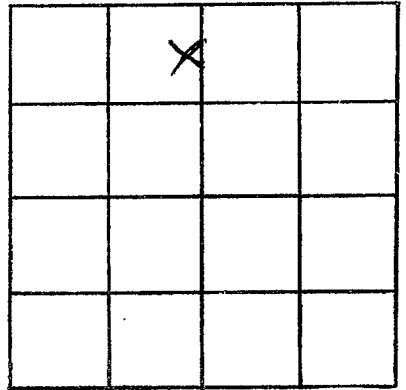

SECTION 12

Please indicate well location X.

ADDITIONAL INFORMATION

If more than one screen,
show locations of each on sketch.