

LEFLORE
 B 37
 8-10-74

MISSISSIPPI
 BOARD OF WATER COMMISSIONERS
 416 North State Street
 Jackson, Mississippi 39201

CODED

WATER WELL DRILLERS LOG

EUTANE GAS CO. OF GREENWOOD LeFlore

8/10/74 19 date well completed firm name county well located

LANDOWNER:
 Reynolds Planting Co.
 Gled Lora
 (mailing address)

description of formations encountered	from	to
Clay	0	20
Sand	20	65
SAND + GRAVEL	65	80

WELL LOCATION:
 sec. 2 T 22 N R 1 E S 5 W
 4 miles NE of M. City
 (distance) (direction) (nearest town)

WELL PURPOSE: Home
 (home, irrigation, municipal, industrial)

WELL COMPLETION DATA:

- diameter (inches) 4"
- total depth (feet) 800
- static water level (feet) 18' below top of ground
- casing PVC 60'
 (material) (depth)
 4" (size) If telescope see back.
- screen 20' 60'
 (length) (depth to top)
 4" PVC (size) (material)
- pump 1 10
 (HP) (yield gpm)
 Elec (type power)
- electric log YES
 (yes or no)

(organization running log)

(8) how well bottom plugged
 PVC Cap


CODED

RECEIVED
 SEP - 3 1974

DRILLERS REMARKS:

If well telescopes please sketch and show depths.

GROUND LEVEL

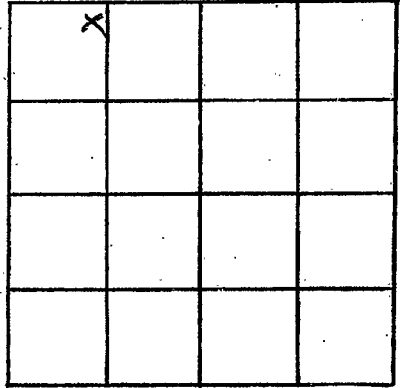

SECTION _____

Please indicate well location X.

ADDITIONAL INFORMATION

Lined area for additional information.

If more than one screen, show locations of each on sketch.