

Leflore
B4
6-66

MISSISSIPPI BOARD OF WATER COMMISSIONERS

WATER WELL DRILLERS LOG

CODED

Date: 6/27, 1966, Driller: Butane Gas Co. County Leflore
(Name)


	Description & Color of Materials Sand, Clay, Red Clay, Shell, etc.	Thick- ness Feet	Depth Feet
(1) Owner of Land: <u>Dan Reynolds</u> (Name) <u>Glendora, Miss.</u> (Address)	<u>Clay</u>	<u>13</u>	<u>13</u>
	<u>Clay and Sand</u>	<u>10</u>	<u>23</u>
(2) Location: <u>NW 1/4, NW 1/4, Sec. 12 T4R W</u>	<u>Coarse Sand</u>	<u>10</u>	<u>33</u>
<u>4</u> miles <u>SE</u> of <u>Glendora</u>	<u>Med. Sand</u>	<u>10</u>	<u>43</u>
(distance) (direction) (Nearest Town)	<u>Med. Sand</u>	<u>10</u>	<u>53</u>
(3) Topography: <input checked="" type="checkbox"/> (Hilly) <input type="checkbox"/> (Flat) <input type="checkbox"/> (Level)	<u>Coarse Sand, Gravel</u>	<u>10</u>	<u>63</u>
(4) Purpose of Well: <u>Irrigation</u> (Domestic Irrigation, Municipal, Industrial, Other)	<u>Coarse Sand, Gravel</u>	<u>10</u>	<u>73</u>
	<u>Coarse Sand, Gravel</u>	<u>10</u>	<u>83</u>
	<u>Coarse Sand, Gravel</u>	<u>10</u>	<u>93</u>
	<u>Coarse Sand, Gravel</u>	<u>10</u>	<u>103</u>

Information upon completion of well:

- (1) Diameter 16 inches.
- (2) Total Depth 103 feet.
- (3) Water Level 22 feet below top of ground.
- (4) Cased to 63, Size 16
- (5) Screen: Size 16, Length 40
- (6) Were any formations sealed against pollution?
no.

If YES depth of formation _____
Why _____
Drillers Remarks: _____

CODED

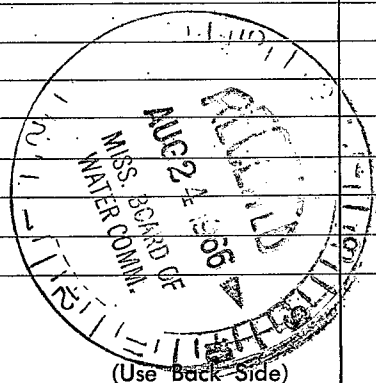

Well No.

(Use Back Side)

