

PJA

LEFLORE
B44
1179

MISSISSIPPI
BOARD OF WATER COMMISSIONERS
416 North State Street
Jackson, Mississippi 39201

CODED

MSW-12869
WATER WELL DRILLERS LOG

Jan 79 19 date well completed Robert E. Rothfuss, Inc. firm name Leflore county well located

LANDOWNER: Mentor City
Water Assoc.

description of formations encountered	from	to
Sand	0	120
Shale	120	200
Sand	200	330
Shale & Sand streaks	330	680
Sand	680	730
Clay	730	790
Sand	790	760
Clay	760	820
Sand	820	840

(mailing address)

WELL LOCATION:
sec 28 T 22 N R 1 E
S
0 miles 0 of Mentor City
(distance) (direction) (nearest town)

WELL PURPOSE: Neerney for
(home, irrigation, municipal, industrial)

- WELL COMPLETION DATA:
- (1) diameter (inches) 12 x 4
 - (2) total depth (feet) 840
 - (3) static water level (feet) 5 below above top of ground.
 - (4) casing steel 680
(material) (depth)
12 if telescope see back.
(size)
 - (5) screen 80 681
(length) (depth to top)
4" SS
(size) (material)
 - (6) pump 30 300
(HP) (yield gpm).
electric
(type power)
 - (7) electric log yes
(yes or no)
State
(organization running log)
 - (8) how well bottom plugged B.P.U.

CODED

Miss. Board of Water Comm.


SEP 12 1979

DRILLERS REMARKS:

RECEIVED

If well telescopes please sketch and show depths.

GROUND LEVEL

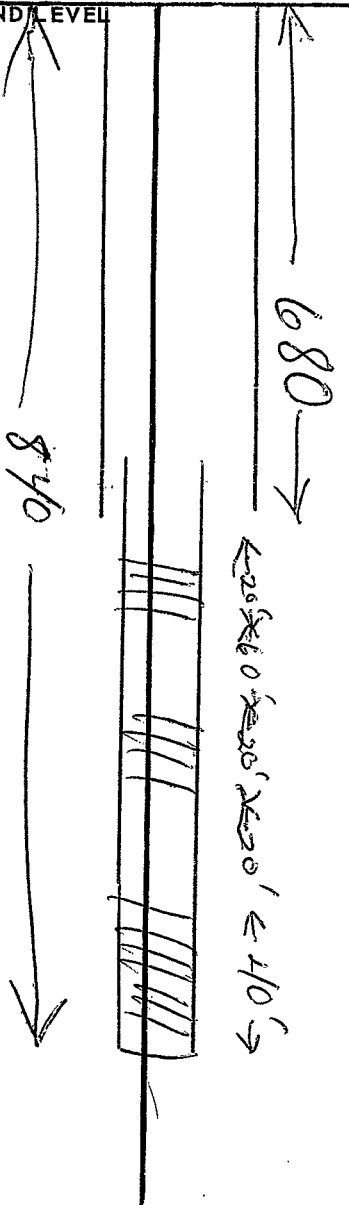

SECTION _____

Please indicate well location X.

ADDITIONAL INFORMATION

If more than one screen, show locations of each on sketch.