

LETLORE
 B-45
 1-18-80
 1-18-80
 date well completed

MISSISSIPPI
 BOARD OF WATER COMMISSIONERS
 416 North State Street
 Jackson, Mississippi 39201

CODED

WATER WELL DRILLERS LOG
 BUTANE GAS COMPANY
 OF GREENWOOD

Letlore
 county well located

LANDOWNER:	description of formations encountered	from	to
Hugh Gritz Farm			
Minden City (mailing address)	SAND	10	80
WELL LOCATION:	SAND & GRAVEL	80	160
sec. <u>9</u> T <u>22</u> N R <u>1</u> E S W	SAND	160	360
<u>2</u> miles <u>N</u> of <u>Minden City</u> (distance) (direction) (nearest town)	SHALE & CLAY	360	440
WELL PURPOSE: <u>Home</u> (home, irrigation, municipal, industrial)	GREEN SAND	440	480
WELL COMPLETION DATA:	SHALE	480	600
(1) diameter (inches) <u>4 x 2</u>	SAND & SHALE	600	760
(2) total depth (feet) <u>1007</u>	FINE BROWN SAND	760	800
(3) static water level (feet) <u>7</u> below above top of ground.	CLAY	800	840
(4) casing <u>Steel</u> , <u>987</u> , (material) (depth) <u>4 x 2</u> if telescope see back. (size)	SAND	840	1014
(5) screen <u>20</u> , <u>987</u> (length) (depth to top) <u>2</u> , <u>stainless</u> (size) (material)			
(6) pump <u>1/2</u> , <u>10</u> (HP) (yield gpm) <u>Electric</u> (type power)			
(7) electric log <u>no</u> (yes or no) (organization running log)			
(8) how well bottom plugged <u>Back Pressure Valve</u>			
DRILLERS REMARKS:			

CODED

DEPT. OF NATURAL RESOURCES
 BUREAU OF LAND & WATER RESOURCES
 RECEIVED
 FEB 11 1980


If well telescopes please sketch and show depths.

GROUND LEVEL

105' - 4" CASING →

882' - 2" CASING →

20' - 2" SCREEN →

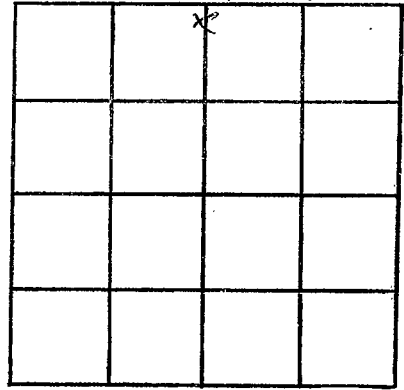

SECTION 9

Please indicate well location X.

ADDITIONAL INFORMATION

If more than one screen, show locations of each on sketch.