


MISSISSIPPI DEPARTMENT OF NATURAL RESOURCES
Bureau of Land and Water Resources
 Southport Mall
 P.O. Box 10631
 Jackson, Mississippi 39209
WATER WELL DRILLERS LOG

CODED

Jefferson
B 52
4-16-81


4-16 19 81 Dyer Jefferson
 date well completed firm name county well located

LANDOWNER:	description of formations encountered	from	to
<i>Pleasant</i>	<i>clay</i>	0	18
<i>Minter City, MS.</i> (mailing/address)	<i>fine sand</i>	18	34
WELL LOCATION: sec. <u>2</u> T <u>22</u> N R <u>1</u> E <u>4</u> miles <u>NW</u> of <u>Minter City</u> (distance) (direction) (nearest town)	<i>med sand & gravel</i>	34	67
WELL PURPOSE: (home, irrigation, municipal, industrial)	<i>sand & gravel</i>	67	113
WELL COMPLETION DATA:	CODED		
(1) diameter (inches) <u>16"</u>			
(2) total depth (feet) <u>113'</u>			
(3) static water level (feet) <u>20</u> below above top of ground.			
(4) casing <u>Steel</u> <u>113'</u> (material) (depth) <u>16"</u> if telescope see back. (size)			
(5) screen <u>40"</u> <u>23'</u> (length) (depth to top)			
<u>16"</u> <u>Steel</u> (size) (material)			
(6) pump <u>60</u> <u>900</u> (HP) (yield gpm)			
(7) electric log _____ (yes or no)			
_____ (organization running log)			
(8) how well bottom plugged <u>plate</u>			
DRILLERS REMARKS:			

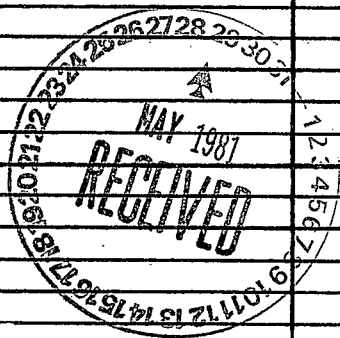

If well telescopes please sketch and show depths.

GROUND LEVEL

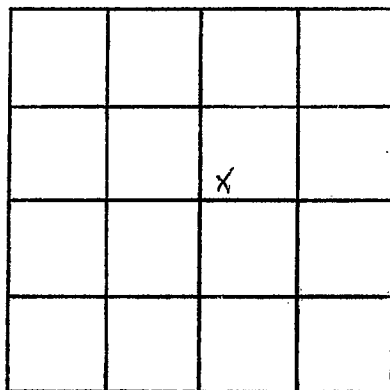

SECTION 7

Please indicate well location X.

ADDITIONAL INFORMATION

If more than one screen,
show locations of each on sketch.