

MISSISSIPPI DEPARTMENT OF NATURAL RESOURCES

Bureau of Land and Water Resources

Southport Mall

P.O. Box 10631

Jackson, Mississippi 39209

WATER WELL DRILLERS LOG

BUTANE GAS CO. OF GREENWOOD

POST OFFICE BOX 1135

GREENWOOD, MISS. 38901

CODED

LeFlore
B-54
12-9-81

12-9-81
date well completed

LeFlore

| LANDOWNER: | description of formations encountered | from | to |
|--|---|---|---|
| <p><i>Sykes Shadwin</i></p> <p>(mailing address)</p> | <p><i>Clay</i></p> <p><i>sand</i></p> <p><i>sand & gravel</i></p> | <p><i>0</i></p> <p><i>10</i></p> <p><i>80</i></p> | <p><i>10</i></p> <p><i>50</i></p> <p><i>104</i></p> |
| WELL LOCATION: | | | |
| <p>sec. <i>14</i> T <i>22N</i> R <i>1E</i></p> <p><i>1.5</i> miles <i>NE</i> of <i>Monticello</i></p> <p>(distance) (direction) (nearest town)</p> | | | |
| WELL PURPOSE: <i>irrigation</i> (home, irrigation, municipal, industrial) | | | |
| WELL COMPLETION DATA: | | | |
| (1) diameter (inches) <i>16"</i> | | | |
| (2) total depth (feet) <i>104</i> | | | |
| (3) static water level (feet) <i>18</i> below above top of ground. | | | |
| (4) casing <i>Steel</i> , <i>64</i> (material) (depth) <i>16"</i> (size) if telescope see back. | | | |
| (5) screen <i>40</i> , <i>64</i> (length) (depth to top) | | | |
| (6) pump <i>16</i> , <i>Steel</i> (size) (material) | | | |
| (7) pump <i>60</i> , <i>1400</i> (HP) (yield gpm) | | | |
| (type power) <i>Diesel</i> | | | |
| (7) electric log <i>No</i> (yes or no) | | | |
| (organization running log) <i>No</i> | | | |
| (8) how well bottom plugged <i>Steel plate</i> | | | |
| DRILLERS REMARKS: <i>Carla Roman</i> | | | |


DEPT. OF NATURAL RESOURCES
BUREAU OF LAND & WATER RESOURCES

DEC 31 1981

RECEIVED

If well telescopes please sketch and show depths.

GROUND LEVEL

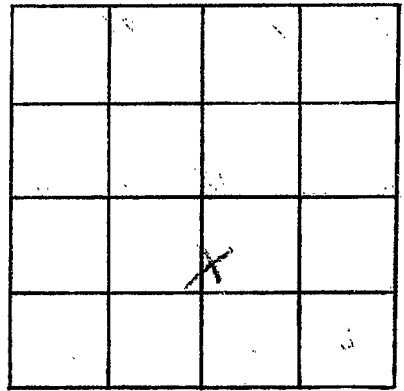

SECTION 14

Please indicate well location X.

ADDITIONAL INFORMATION

If more than one screen, show locations of each on sketch.