

Jefflore
B 56

MISSISSIPPI DEPARTMENT OF NATURAL RESOURCES
 Bureau of Land and Water Resources
 Southport Mall
 P.O. Box 10631
 Jackson, Mississippi 39209
WATER WELL DRILLERS LOG CODED

June 4 1981 Dyer Well + Irrigation Jefflore
 date well completed firm name county well located

LANDOWNER: Howard Britt

Minter City
 (mailing address)

WELL LOCATION:
 sec. 6 T 22 N S R 1 E W
N.W. miles 4 of Minter City
 (distance) (direction) (nearest town)

WELL PURPOSE: Irrigation
 (home, irrigation, municipal, industrial)

WELL COMPLETION DATA:

- (1) diameter (inches) 10 3/4"
- (2) total depth (feet) 113
- (3) static water level (feet) 13 below above top of ground.
- (4) casing Steel (material), (depth) 10 3/4" if telescope see back. (size)
- (5) screen 40' (length), (depth to top) 10 3/4" Mild Steel (size), (material)
- (6) pump 20 (HP), 1500 (yield gpm)
diesel (type power)
- (7) electric log No (yes or no)
 (organization running log)
- (8) how well bottom plugged Plate


description of formations encountered	from	to
Clay	0	13
Clay	13	23
Clay	23	33
Sand + Clay	33	43
Sand + Clay	43	53
Sand	53	63
Course sand	63	73
Course sand	73	83
Course sand	83	93
Course sand	93	103
Sand & Gravel	103	113

DRILLERS REMARKS:

DEPT OF NATURAL RESOURCES
 BUREAU OF LAND & WATER RESOURCES
 MAY - 4 1982
RECEIVED

If well telescopes please sketch and show depths.

GROUND LEVEL

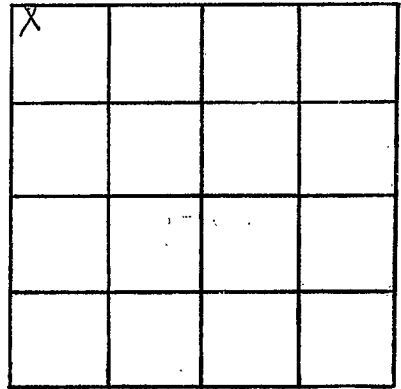

SECTION 6

Please indicate well location X.

ADDITIONAL INFORMATION

If more than one screen, show locations of each on sketch.