

MISSISSIPPI DEPARTMENT OF NATURAL RESOURCES

Bureau of Land and Water Resources

Southport Mall

P.O. Box 10631

Jackson, Mississippi 39209

WATER WELL DRILLERS LOG

CODED

Leflore
B 57

5-14 1982 date well completed Oper Well firm name Leflore county well located

LANDOWNER: *Ronald Conway*

(mailing address)

| description of formations encountered | from | to |
|---------------------------------------|-----------|------------|
| <i>Clay</i> | <i>0</i> | <i>18</i> |
| <i>fine sand</i> | <i>18</i> | <i>34</i> |
| <i>fine sand</i> | <i>34</i> | <i>40</i> |
| <i>sand & gravel</i> | <i>40</i> | <i>110</i> |

WELL LOCATION:
sec *30* T *22* N R *L* E
S *W* W *(W)*
0.2 miles *W* of *Minter City*
(distance) (direction) (nearest town)

WELL PURPOSE:
(home, irrigation, municipal, industrial)


- WELL COMPLETION DATA:
- (1) diameter (inches) *16*
 - (2) total depth (feet) *110*
 - (3) static water level (feet) *15* below above top of ground.
 - (4) casing *Steel*, *80*,
(material) (depth)
16 If telescope see back.
(size)
 - (5) screen *40*, *70*
(length) (depth to top)
16, *Mill Steel*
(size) (material)
 - (6) *gear* pump *60* *3,000*
(HP) (yield gpm)
diesel
(type power)
 - (7) electric log *No*
(yes or-no)
 - (organization running log)
 - (8) how well bottom plugged *plate*

DRILLERS REMARKS:

DEPT. OF NATURAL RESOURCES
BUREAU OF LAND & WATER RESOURCES
SEP 30 1982
RECEIVED

If well telescopes please sketch and show depths.

GROUND LEVEL

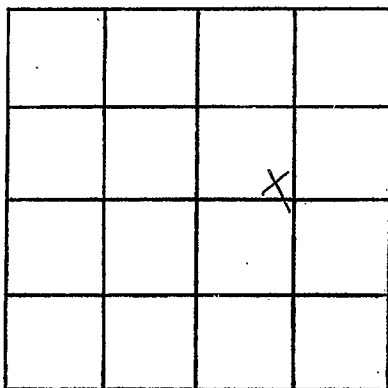

SECTION 30

Please indicate well location X.

ADDITIONAL INFORMATION

If more than one screen,
show locations of each on sketch.