

MISSISSIPPI DEPARTMENT OF NATURAL RESOURCES
Bureau of Land and Water Resources
 Southport Mall
 P.O. Box 10631
 Jackson, Mississippi 39209
WATER WELL DRILLERS LOG

CODED

LeFlore
B 59

7-12-19 Super Well LeFlore
 date well completed firm name county well located

LANDOWNER: <u>Hal Pleasants</u>	description of formations encountered	from	to
(mailing address)	17-41-20-00		
WELL LOCATION: sec. <u>9</u> T. <u>22</u> N. R. <u>1</u> E <u>1 1/2</u> miles <u>S</u> of <u>Blendale</u> (distance) (direction) (nearest town)	0-38 <u>CLAY</u> 0 21 <u>FINE SAND</u> 21 44 <u>SAND</u> 44 103		
WELL PURPOSE: (home, irrigation, municipal, industrial)			
WELL COMPLETION DATA:			
(1) diameter (inches) <u>16</u>			
(2) total depth (feet) _____			
(3) static water level (feet) <u>18</u> below top of ground.			
(4) casing <u>Steel</u> (material), _____ (depth), <u>16</u> (size) if telescope see back.			
(5) screen <u>40</u> (length), _____ (depth to top), <u>16</u> (size), <u>mild Steel</u> (material)			
(6) pump <u>100</u> (HP), <u>1200</u> (yield gpm), <u>diesel</u> (type power)			
(7) electric log <u>No</u> (yes or no)			
(organization running log) _____			
(8) how well bottom plugged <u>Plate</u>			
DRILLERS REMARKS: _____			


DEPT. OF NATURAL RESOURCES
 BUREAU OF LAND & WATER RESOURCES

SEP 30 1982

RECEIVED

If well telescopes please
sketch and show depths.

GROUND LEVEL

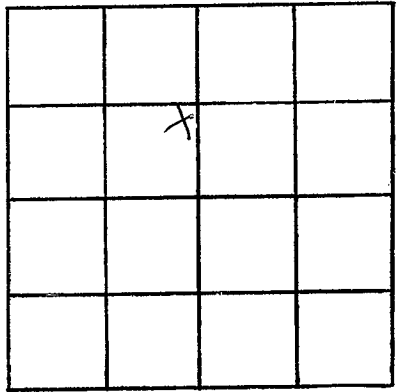

SECTION 9

Please indicate well location X.

ADDITIONAL INFORMATION

If more than one screen,
show locations of each on sketch.