

MISSISSIPPI DEPARTMENT OF NATURAL RESOURCES

Bureau of Land and Water Resources

Southport Mall

P.O. Box 10631

Jackson, Mississippi 39209

WATER WELL DRILLERS LOG

CODED

<i>Leflore</i>
<i>B 60</i>

*7-12-82* 1982  
date well completed

*Dyer Well*  
firm name

*Leflore*  
county well located

LANDOWNER: *Hal Pleasant*

description of formations encountered

from

to

*Clay* *38* *48*  
*Sand & Gravel* *38* *100*

(mailing address)

WELL LOCATION:

sec. *8* T *22* (N) R *1* E  
S (W)  
*2 1/2* miles *SW* of *Blenda*  
(distance) (direction) (nearest town)

WELL PURPOSE:

(home, irrigation, municipal, industrial)

WELL COMPLETION DATA:

- (1) diameter (inches) *16*
- (2) total depth (feet) *100*
- (3) static water level (feet) *18* below above top of ground.
- (4) casing *Steel* (material), (depth),  
*16* If telescope see back. (size)
- (5) screen *40* (length), (depth to top)  
*16* *Mild Steel* (size) (material)
- (6) pump *100* *1200* (HP) (yield gpm)  
*diesel* (type power)
- (7) electric log *No* (yes or no)

(organization running log)

(8) how well bottom plugged *late*

DEPT. OF NATURAL RESOURCES  
BUREAU OF LAND & WATER RESOURCES


SEP 30 1982

DRILLERS REMARKS:

RECEIVED

If well telescopes please sketch and show depths.

GROUND LEVEL

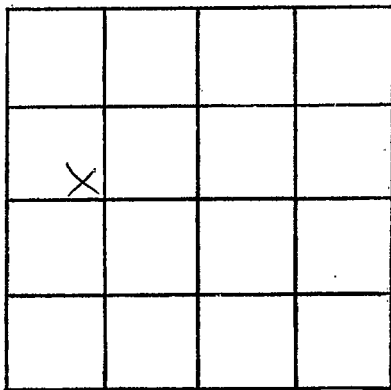

SECTION 8

Please indicate well location X.

ADDITIONAL INFORMATION

If more than one screen,  
show locations of each on sketch.